


T.24 S. R. 5 W. W.M. SECTION 33

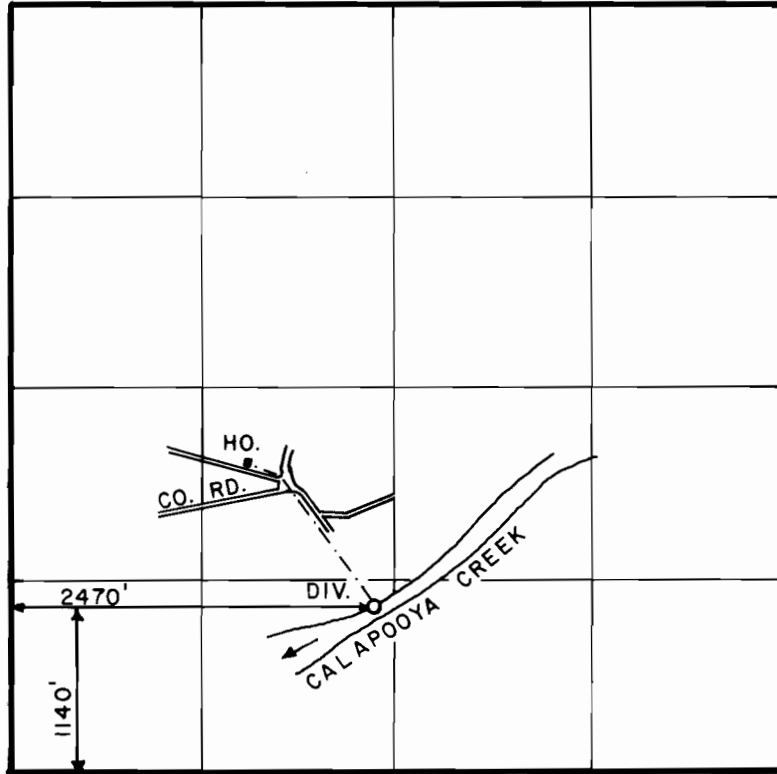

SCALE: 4" = 1 MILE

FINAL PROOF SURVEY UNDER

Application No. 60501 Permit No. 45321
IN NAME OF

LADDIE CRIPPEN

Surveyed OCT. 14 1986, by J. M. SCHMORDE