


T.5S., R.6W., W.M.

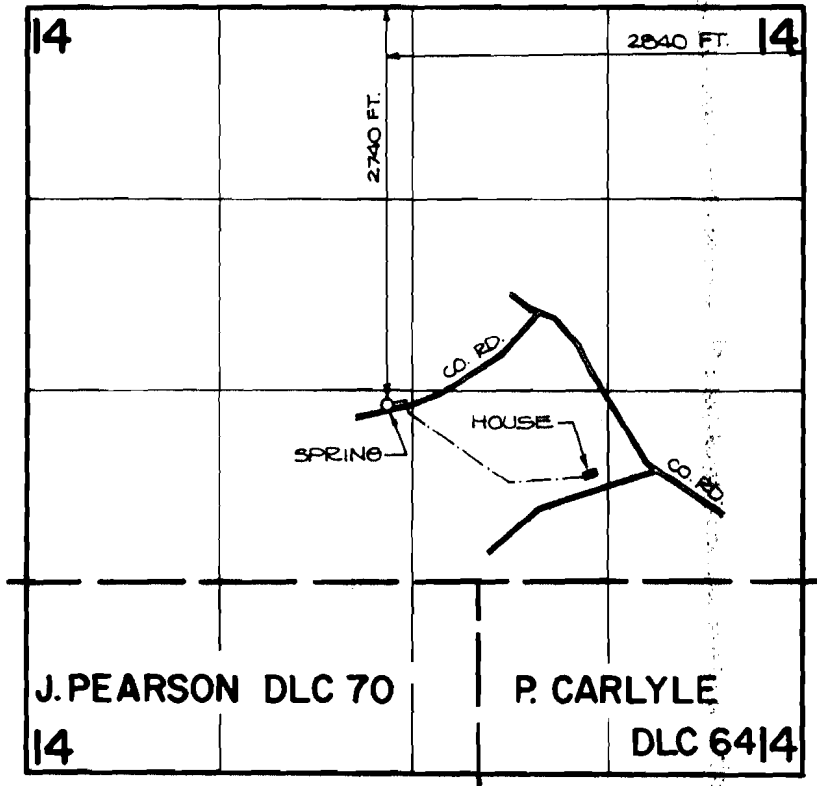

SCALE: 4" = 1 MILE

FINAL PROOF SURVEY
UNDER

Application No. 60932 Permit No. 45357
IN NAME OF

EARL H. SMITH

Surveyed OCT. 25, 1984, by P. Fagan