


T. 3S., R. 40E., W. M.

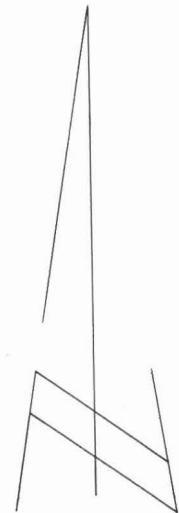

SCALE 1" = 1320'

FINAL PROOF SURVEY UNDER

Application No. **59494** Permit No. **45374**
IN NAME OF

RAYMOND CARPENTER

Surveyed *4-7* 19*87*, by *V.L. Church*