


T. 32 S. R. 6 W. W.M.

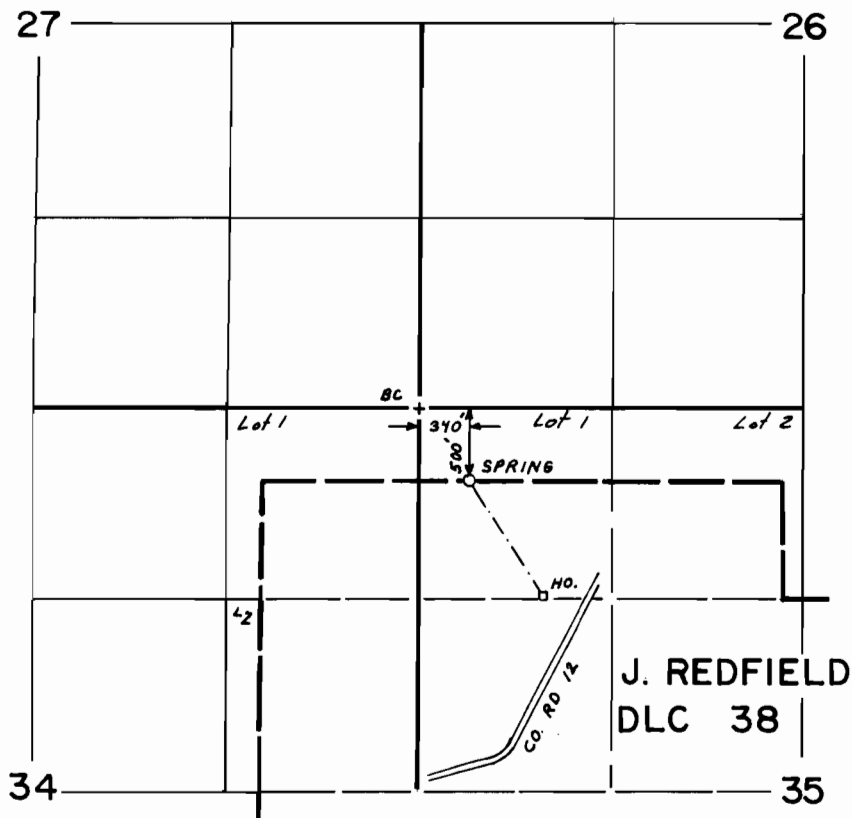

SCALE: 4" = 1 mile

FINAL PROOF SURVEY
UNDER

Application No. 60938 Permit No. 45403.....
IN NAME OF

DANIEL MORIARTY

Surveyed NOV. 30, 1983, by J. E. Cashion.....
DEC. 1,