


T. 32 S., R. 4 W., W.M.

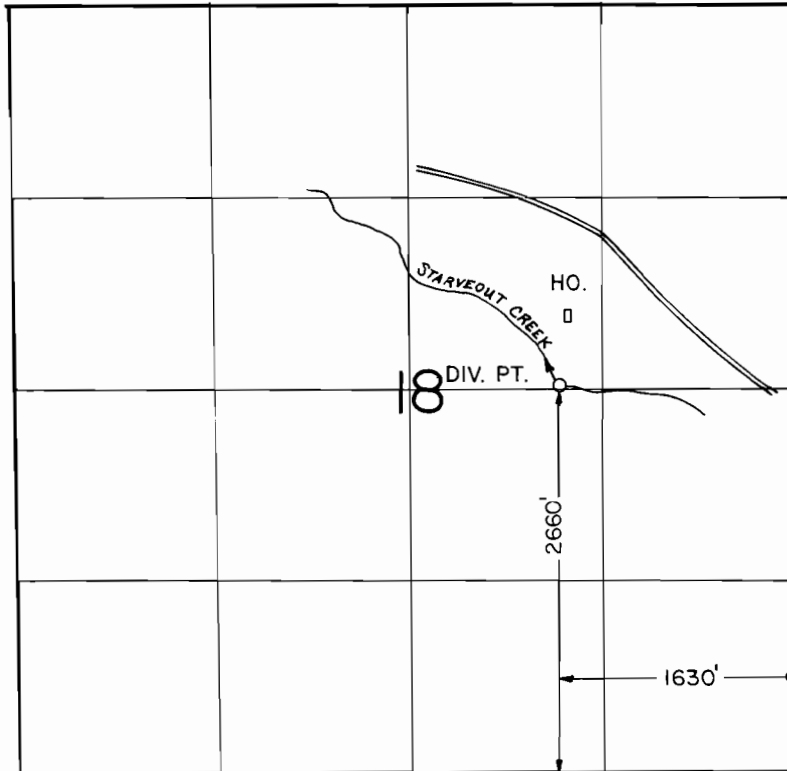

SCALE 1" = 1320'

FINAL PROOF SURVEY
UNDER

Application No. 60980.. Permit No. 45480.....
IN NAME OF

JAMES P. LEAHY

Surveyed NOV. 18, 1983, by L. E. CASHION.