


T.18S.,R.5W.,W.M.

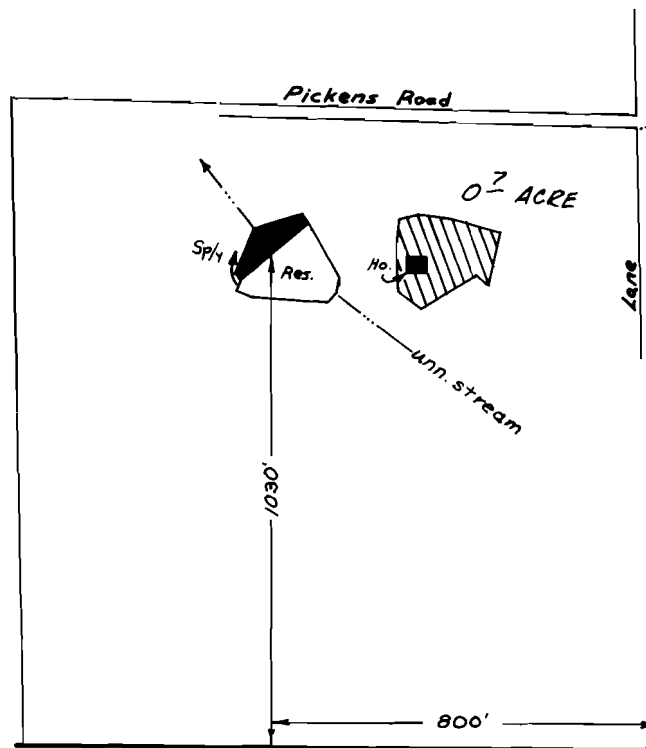

SE 1/4 SE 1/4
SECTION 9

SCALE - 1" = 400'

FINAL PROOF SURVEY
UNDER

R-56556 R-6660
Application No. 56557 Permit No. 42012
IN NAME OF

JOSEPH MAHLER

Surveyed Sept. 16, 1981, by S.C. BROWN