


T. 7 S. R. 1 W. W. M.

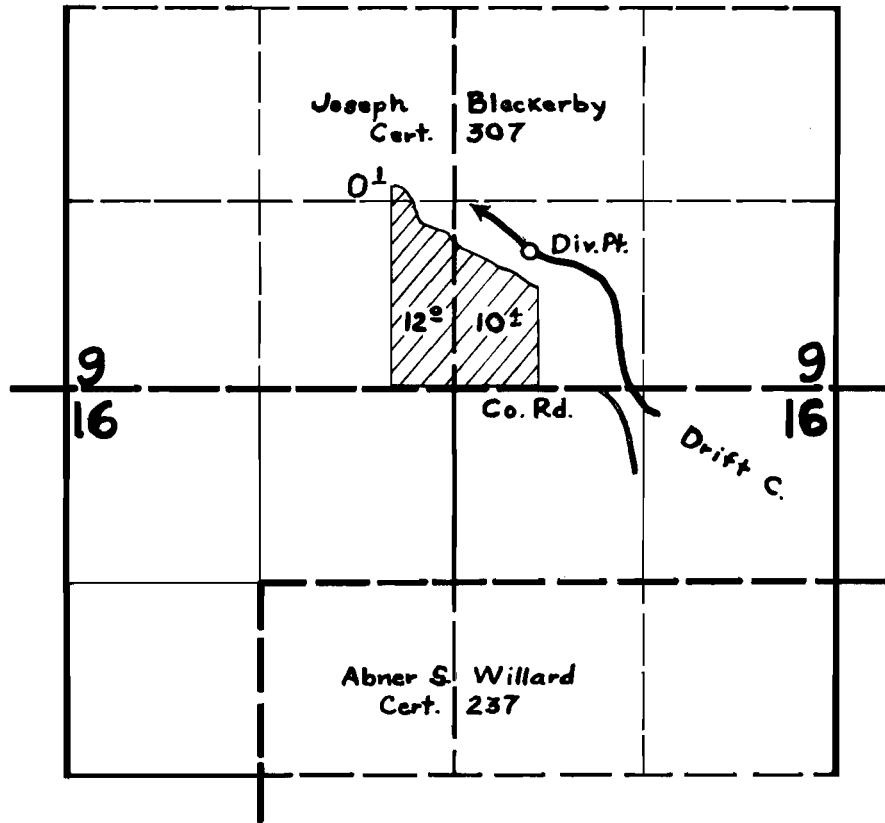

FINAL PROOF SURVEY

UNDER

Application No. 23682 Permit No. 18707

IN NAME OF

RALPH PLANE

Surveyed 29 Feb. 1956, by M. Bish