


T. 39 S., R. 8 W., W. M.

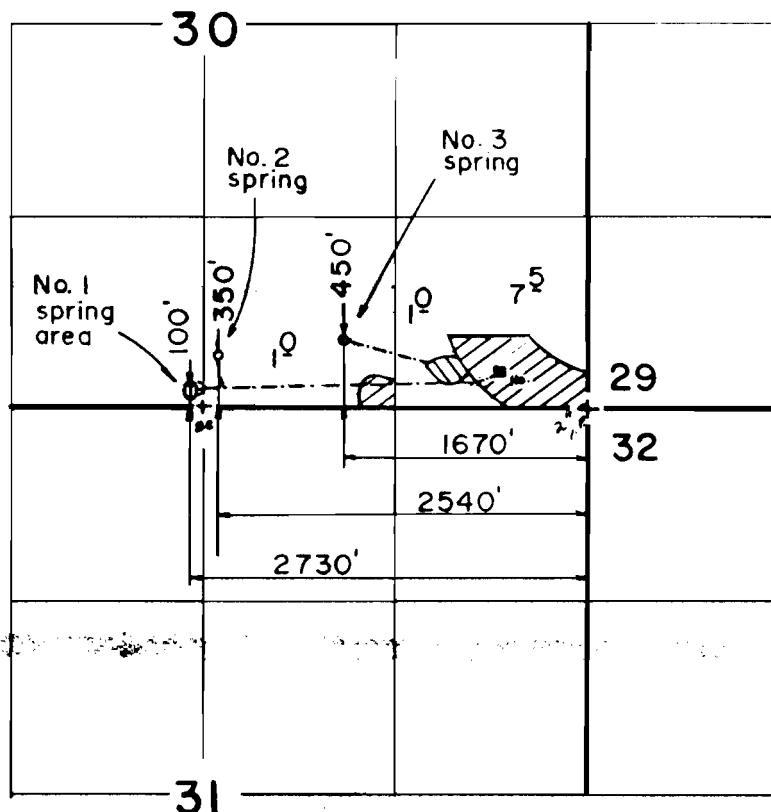

Scale: 1" = 1320'

P. 39212

P. 41234



P. 46394



FINAL PROOF SURVEY

UNDER

52027

39212

54882

41234

Application No. 60519 Permit No. 46394

IN NAME OF

EDNA MILAR DIVELEY

Surveyed APR. 1, 1986, by B. S. JAMES