


SECTION 7
SE SE

5124 - Definite As

TOWNSHIP 22S, RANGE 32½ E, W. M.

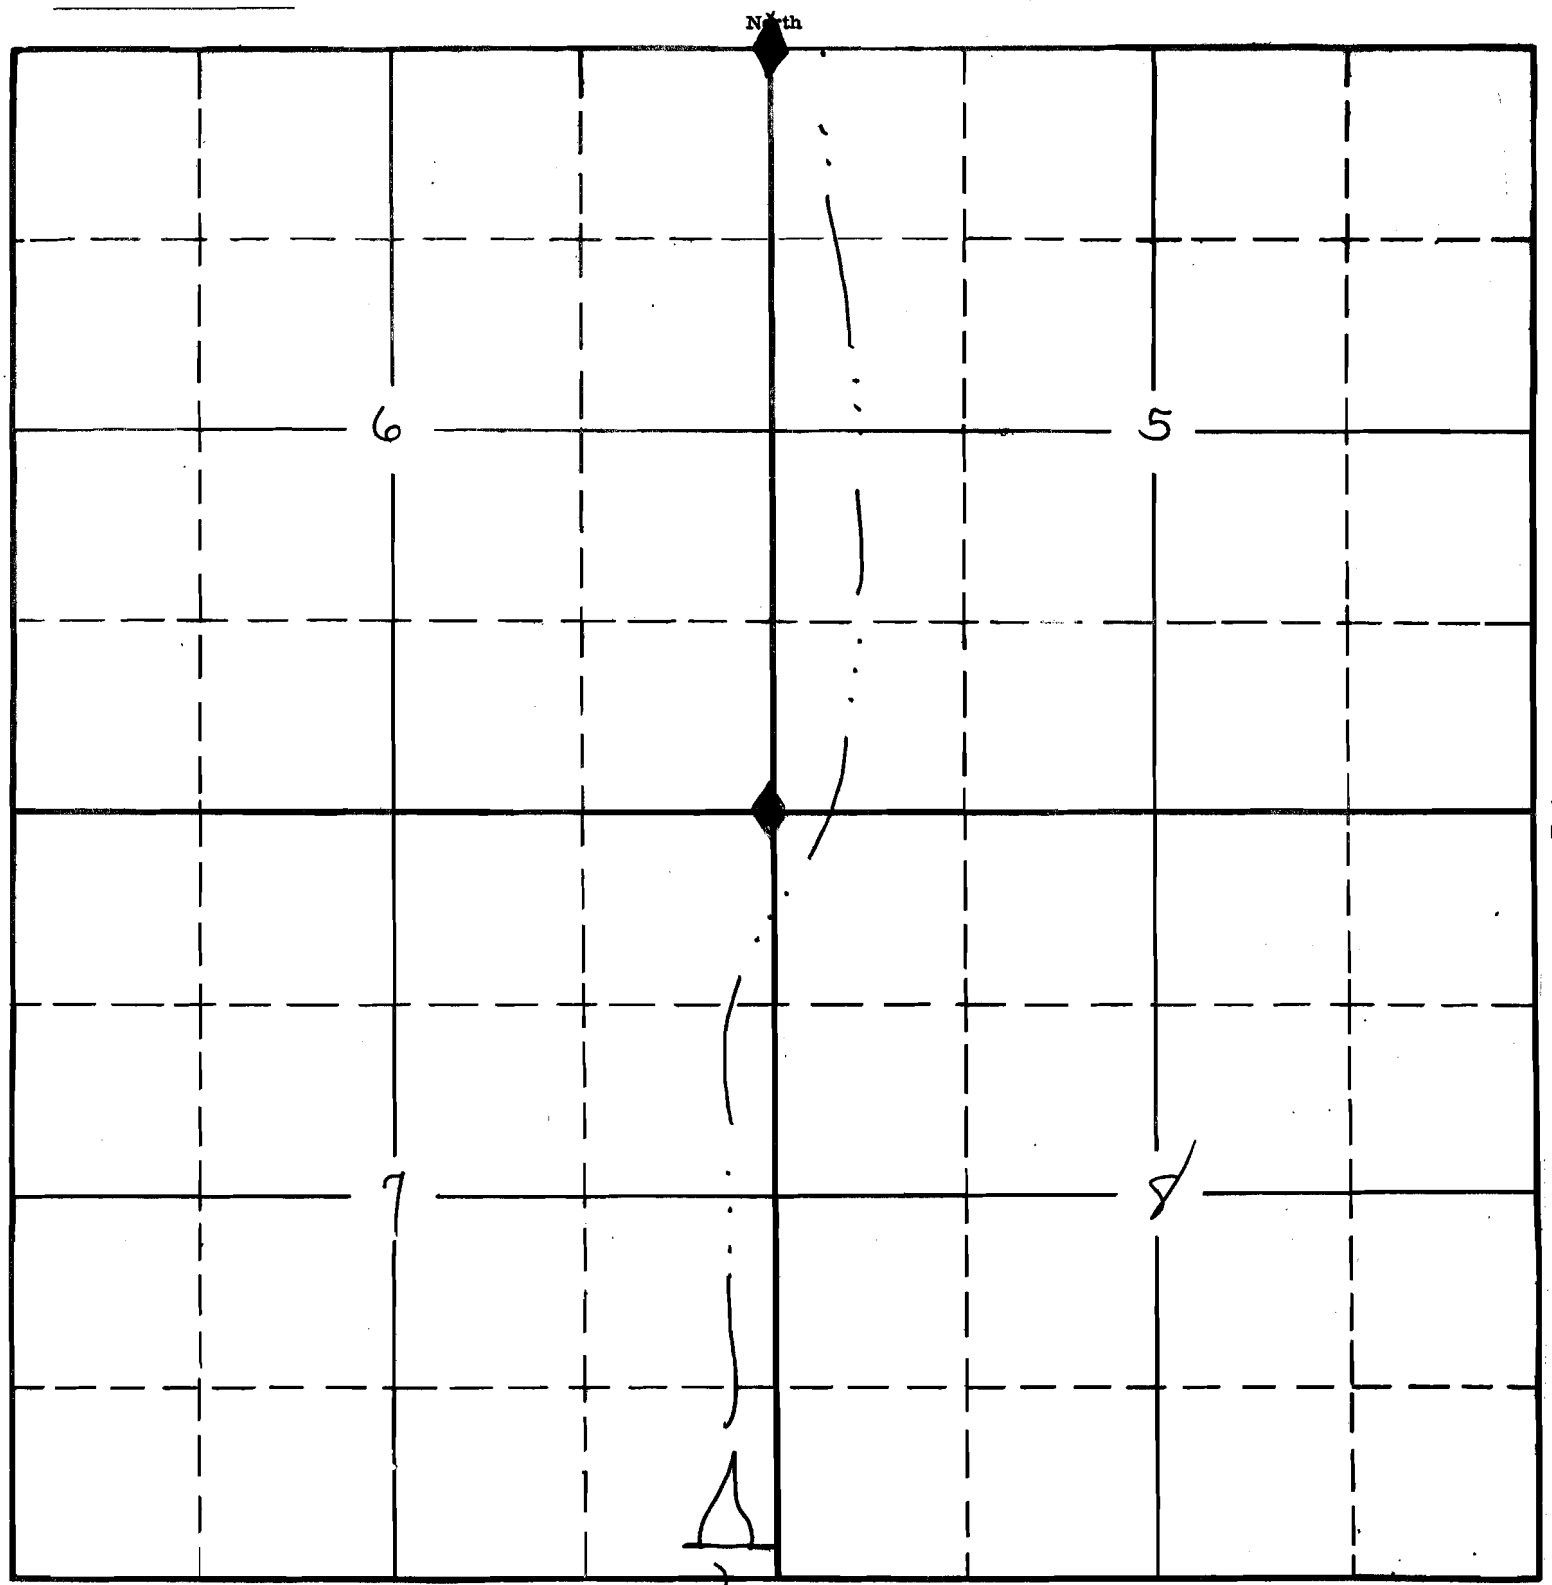

South

RECEIVED
SEP 19 1983
WATER RESOURCES DEPT.
SALEM, OREGON

APPLICATION No. R-66169
PERMIT No.
R 9652