

Form A1-187
March 1961

UNITED STATES
DEPARTMENT OF THE INTERIOR
BUREAU OF LAND MANAGEMENT

SECTION 8


Oregon State Water Filings

NE 1/4 NE 1/4

TOWNSHIP 19S, RANGE 36E, W. M.

North

Castle

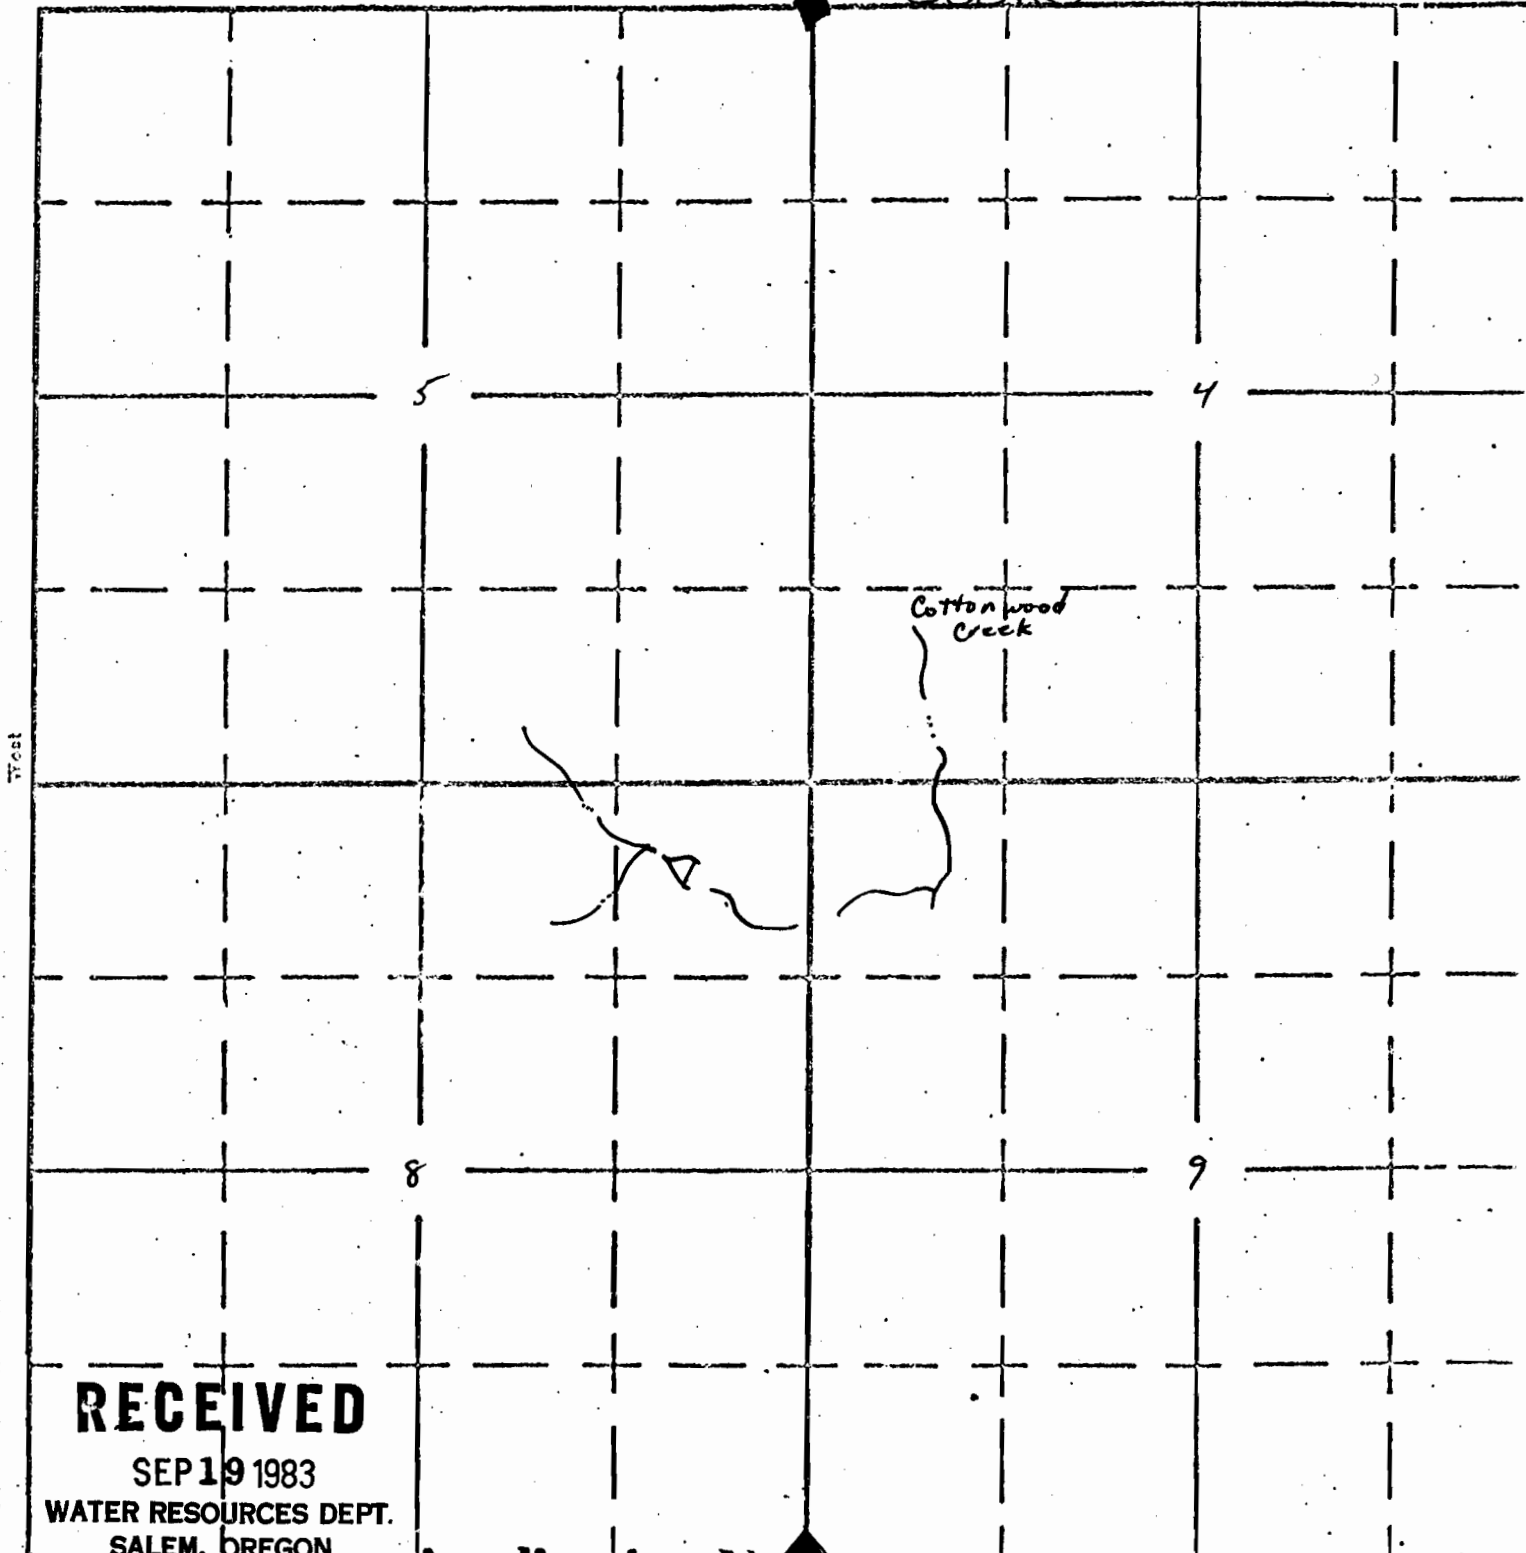

RECEIVED

SEP 19 1983

WATER RESOURCES DEPT.
SALEM, OREGON

Application No. R-66178
Permit No. R 9658

APPLICATION No.