


DEPARTMENT OF THE INTERIOR
BUREAU OF LAND MANAGEMENT

SECTION 6
SW SW

Oregon State Water Filings

TOWNSHIP 24 S, RANGE 35 E, W. M.

North 5195 Rocky Road

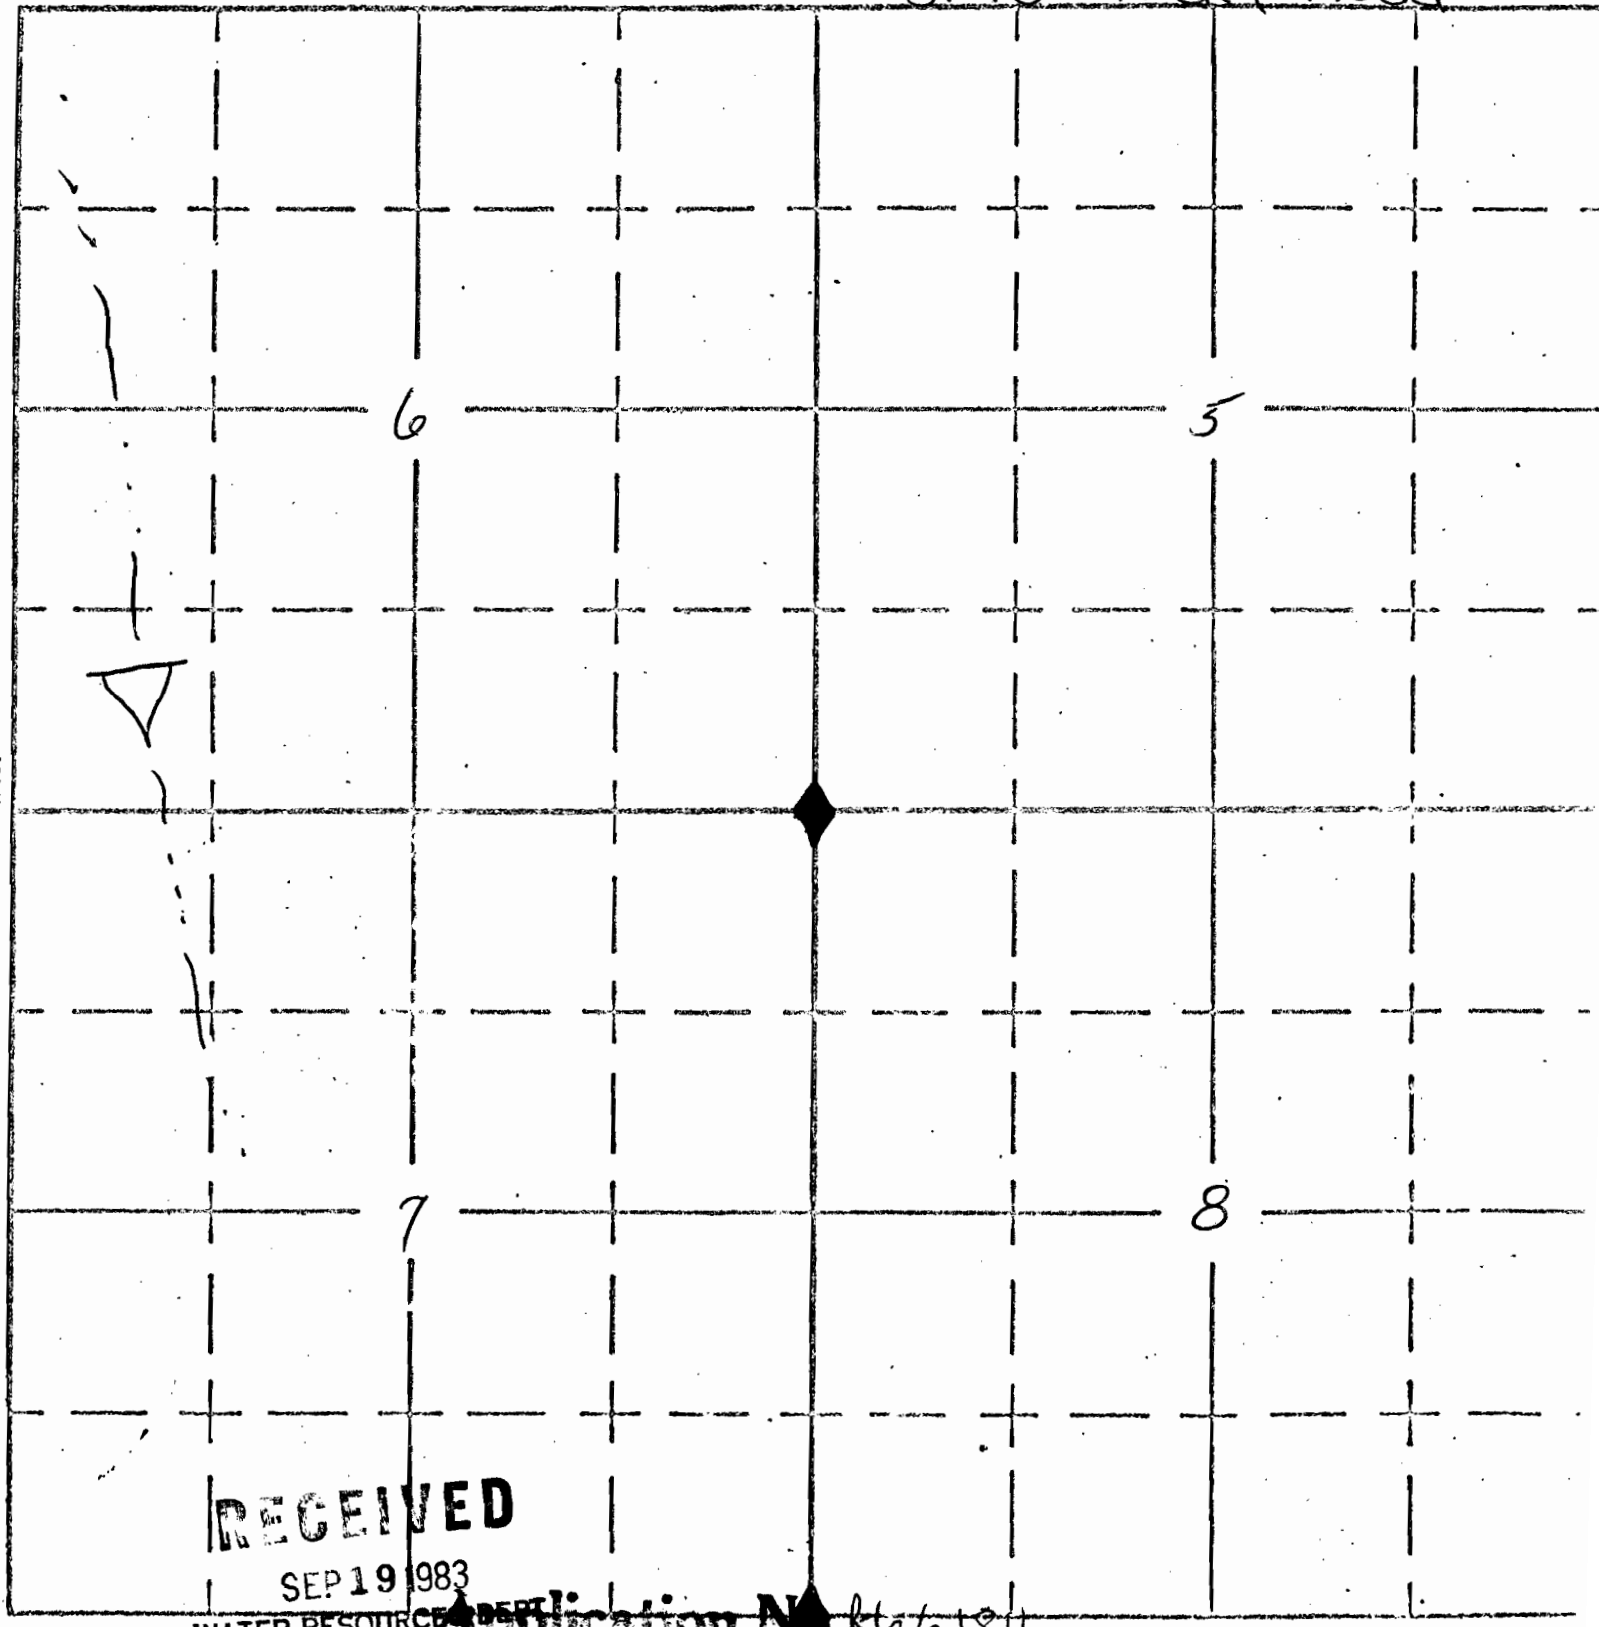

RECEIVED

SEP 19 1983

WATER RESOURCE
SALEM, OREGON

Application No. 866184

Permit No. R 9663

APPLICATION NO.