

DEPARTMENT OF THE INTERIOR
BUREAU OF LAND MANAGEMENT

SECTION 7


Oregon State Water Filings

NE 3E

TOWNSHIP 24S, RANGE 35E, W. M.

North

5193 Longhorn

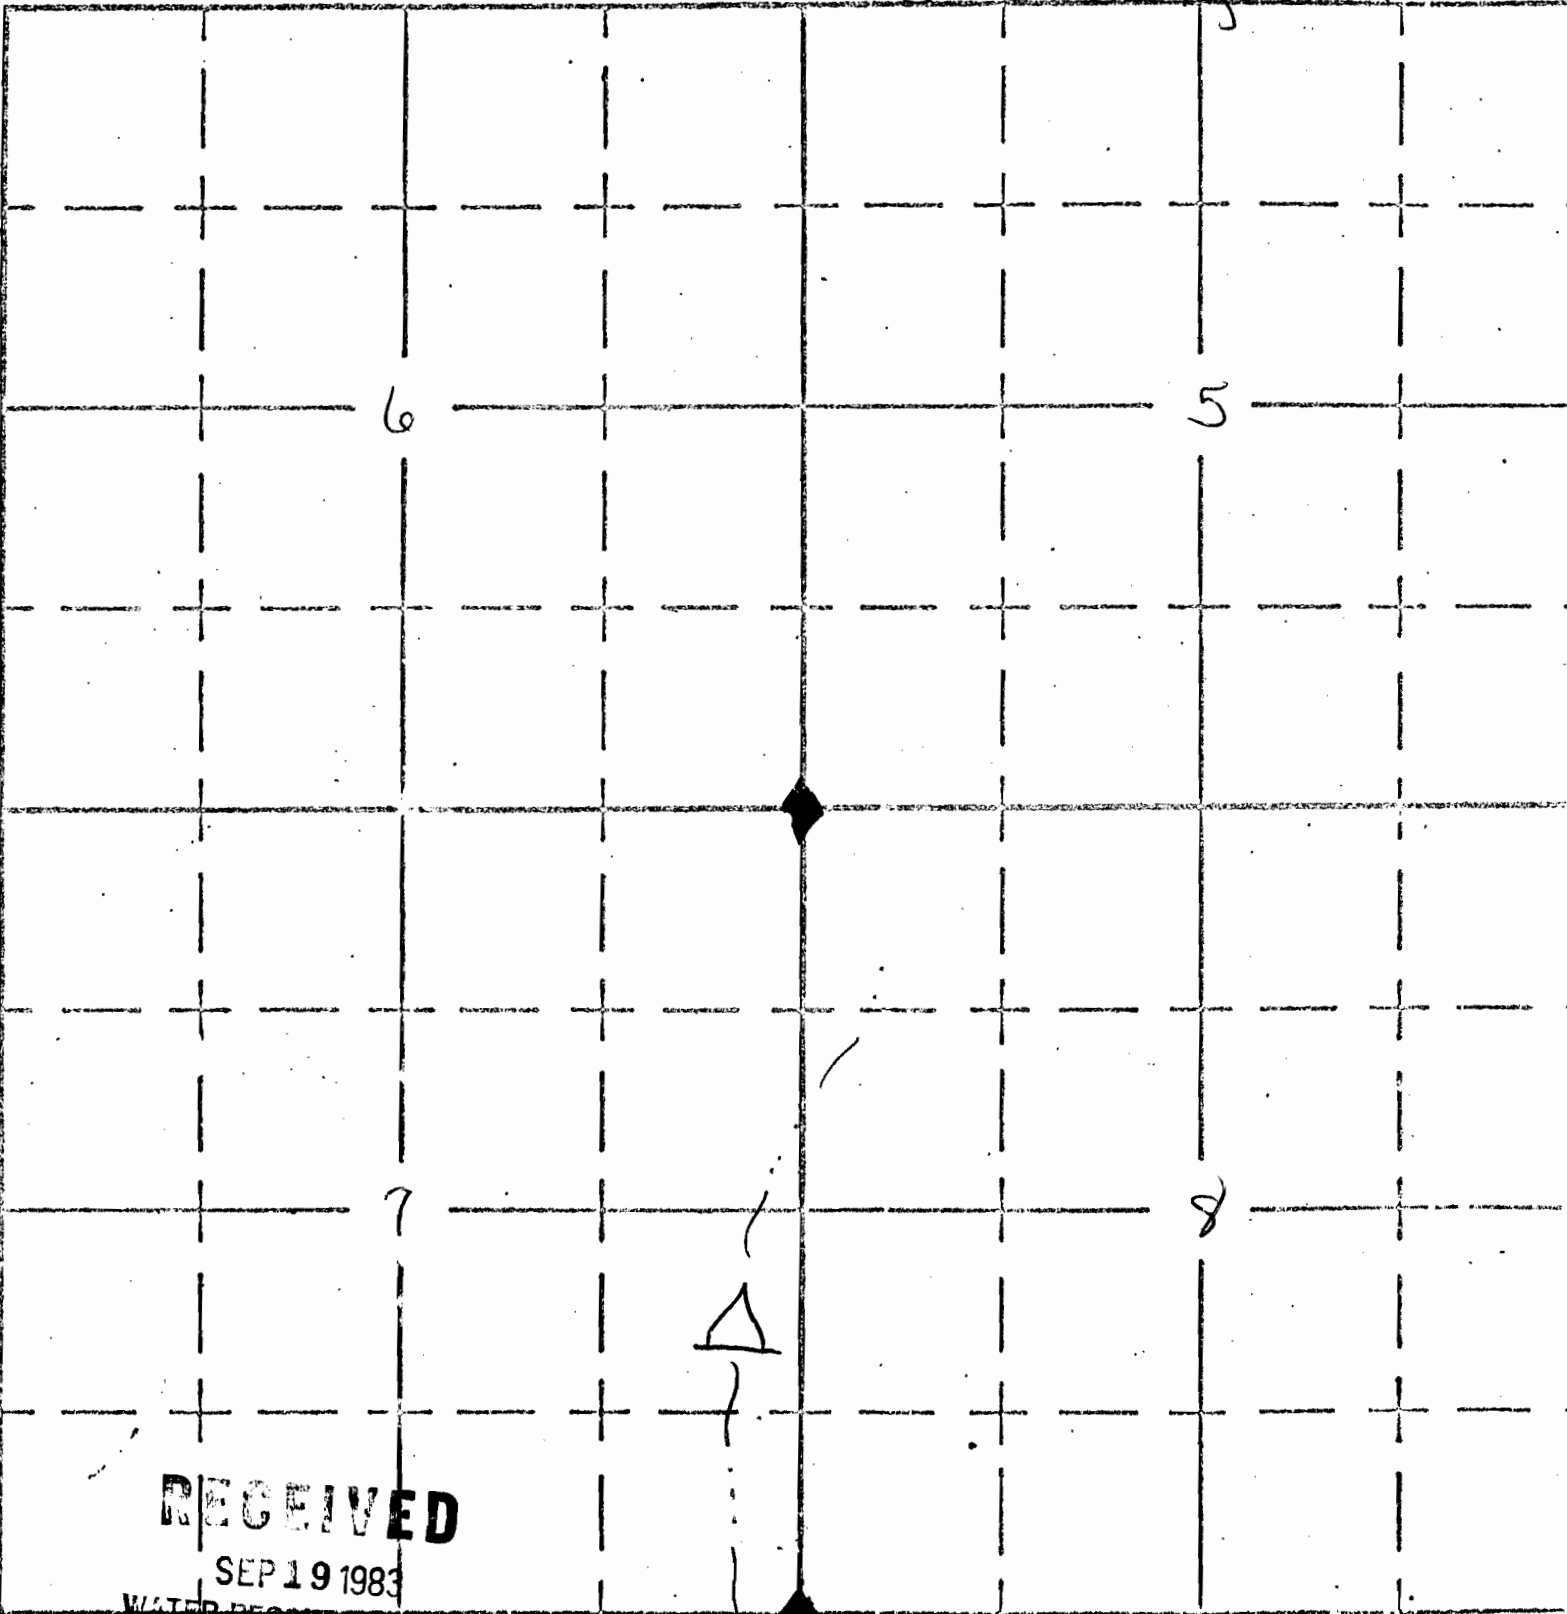

RECEIVED

SEP 19 1983

WATER RESOURCES DEPT
SALEM, OREGON

Application No. R-66186

Permit No. R 9665

APPLICATION No.