


DEPARTMENT OF THE INTERIOR
BUREAU OF LAND MANAGEMENT

SECTION 24
SW 1/4 NE 1/4

Oregon State Water Filings

TOWNSHIP 23 S, RANGE 36 E, W. M.

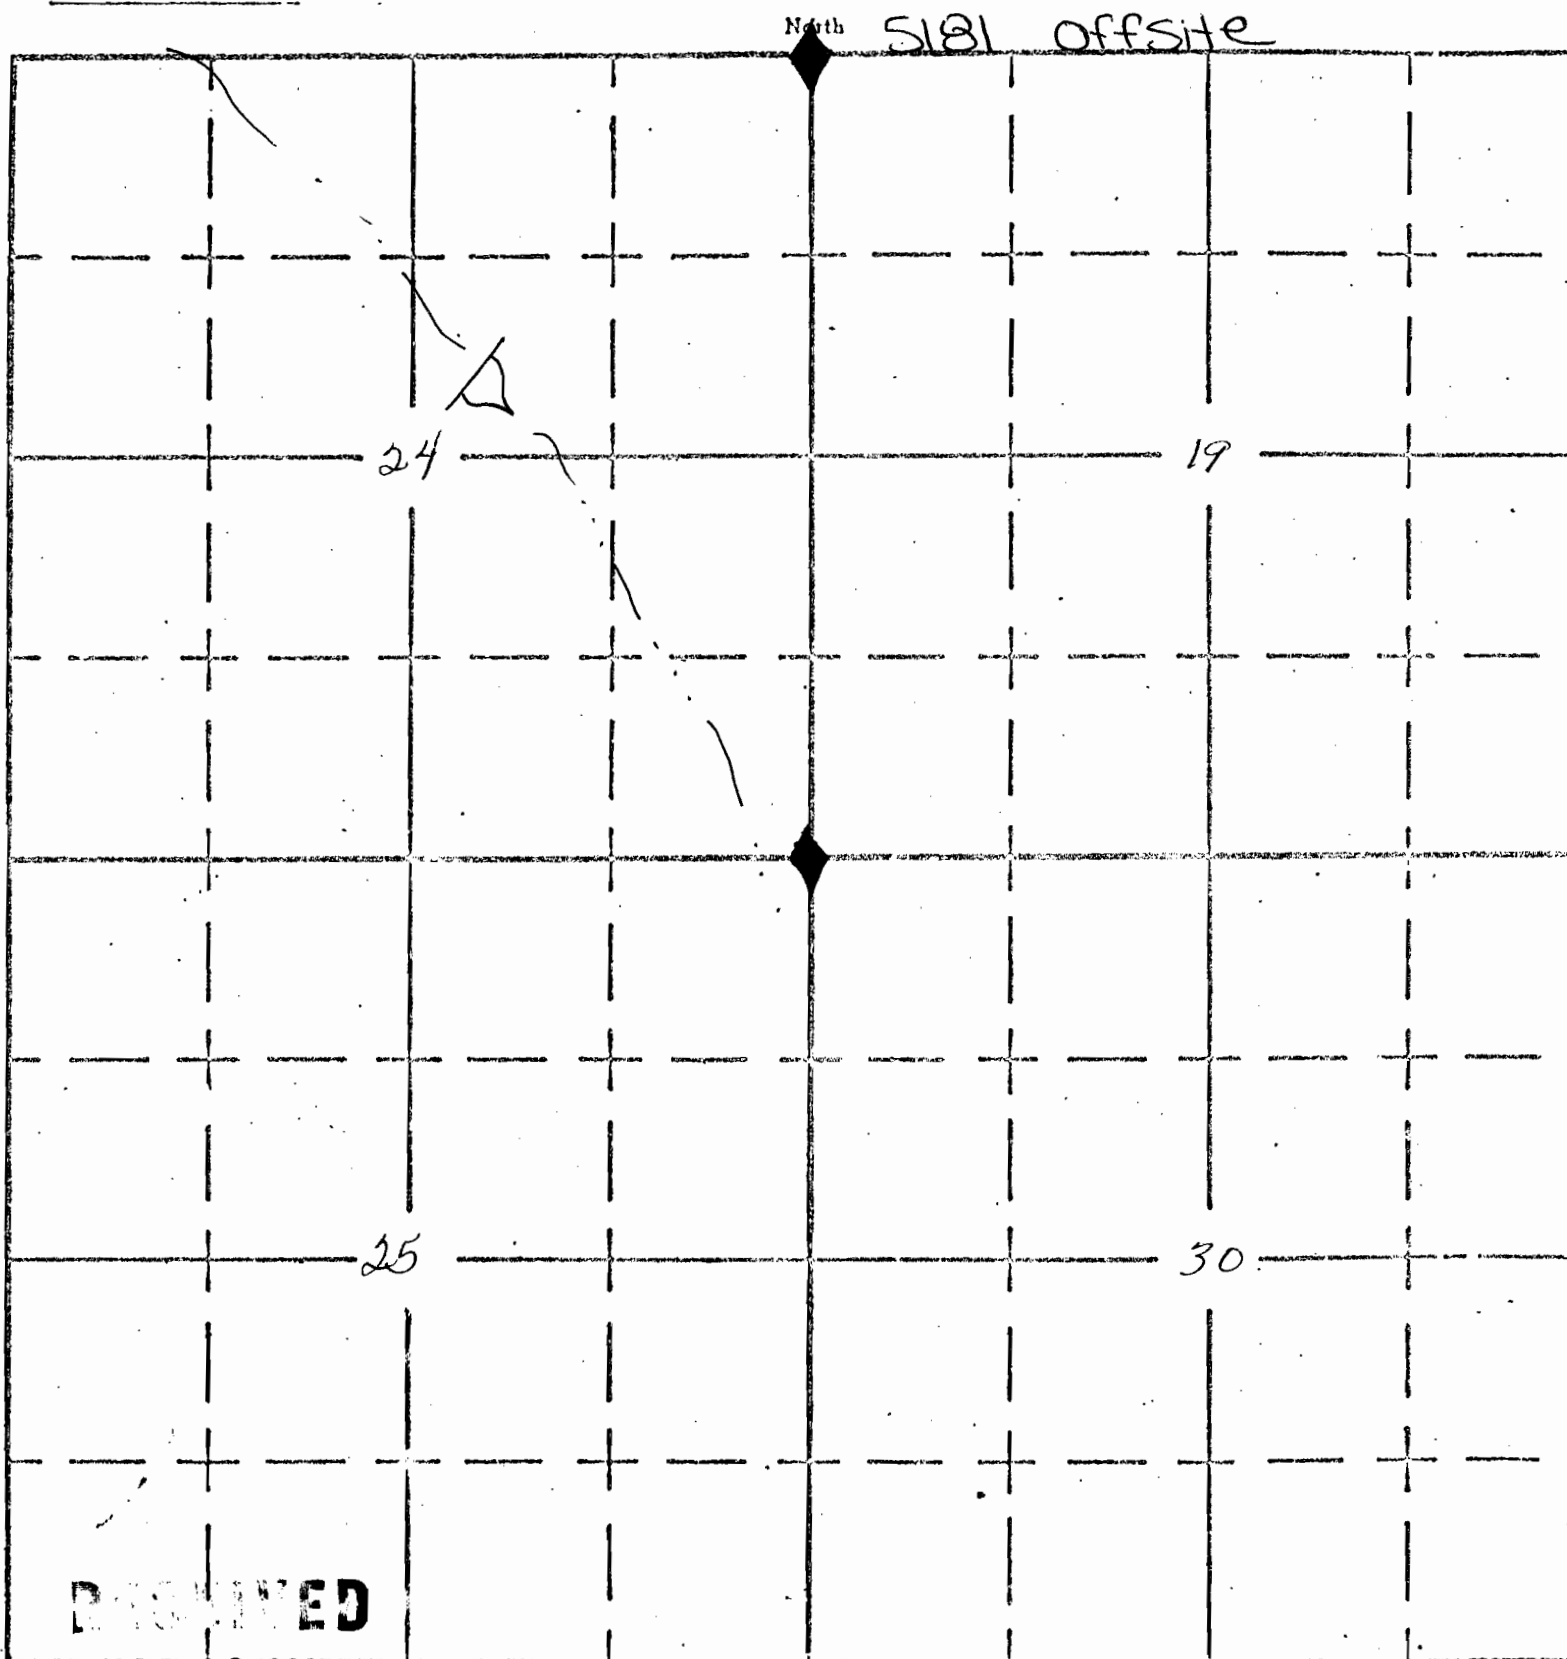

RECEIVED

SEP 19 1983
WATER RESOURCES DEPT.
SALLM, OREGON

Application No. R-666194
Permit No. R 9673

APPLICATION No.