

DEPARTMENT OF THE INTERIOR
BUREAU OF LAND MANAGEMENT


SECTION 3
NW SE

Oregon State Water Filings

TOWNSHIP 21 S, RANGE 33 E, W. M.

North

5160 Elephant Butte

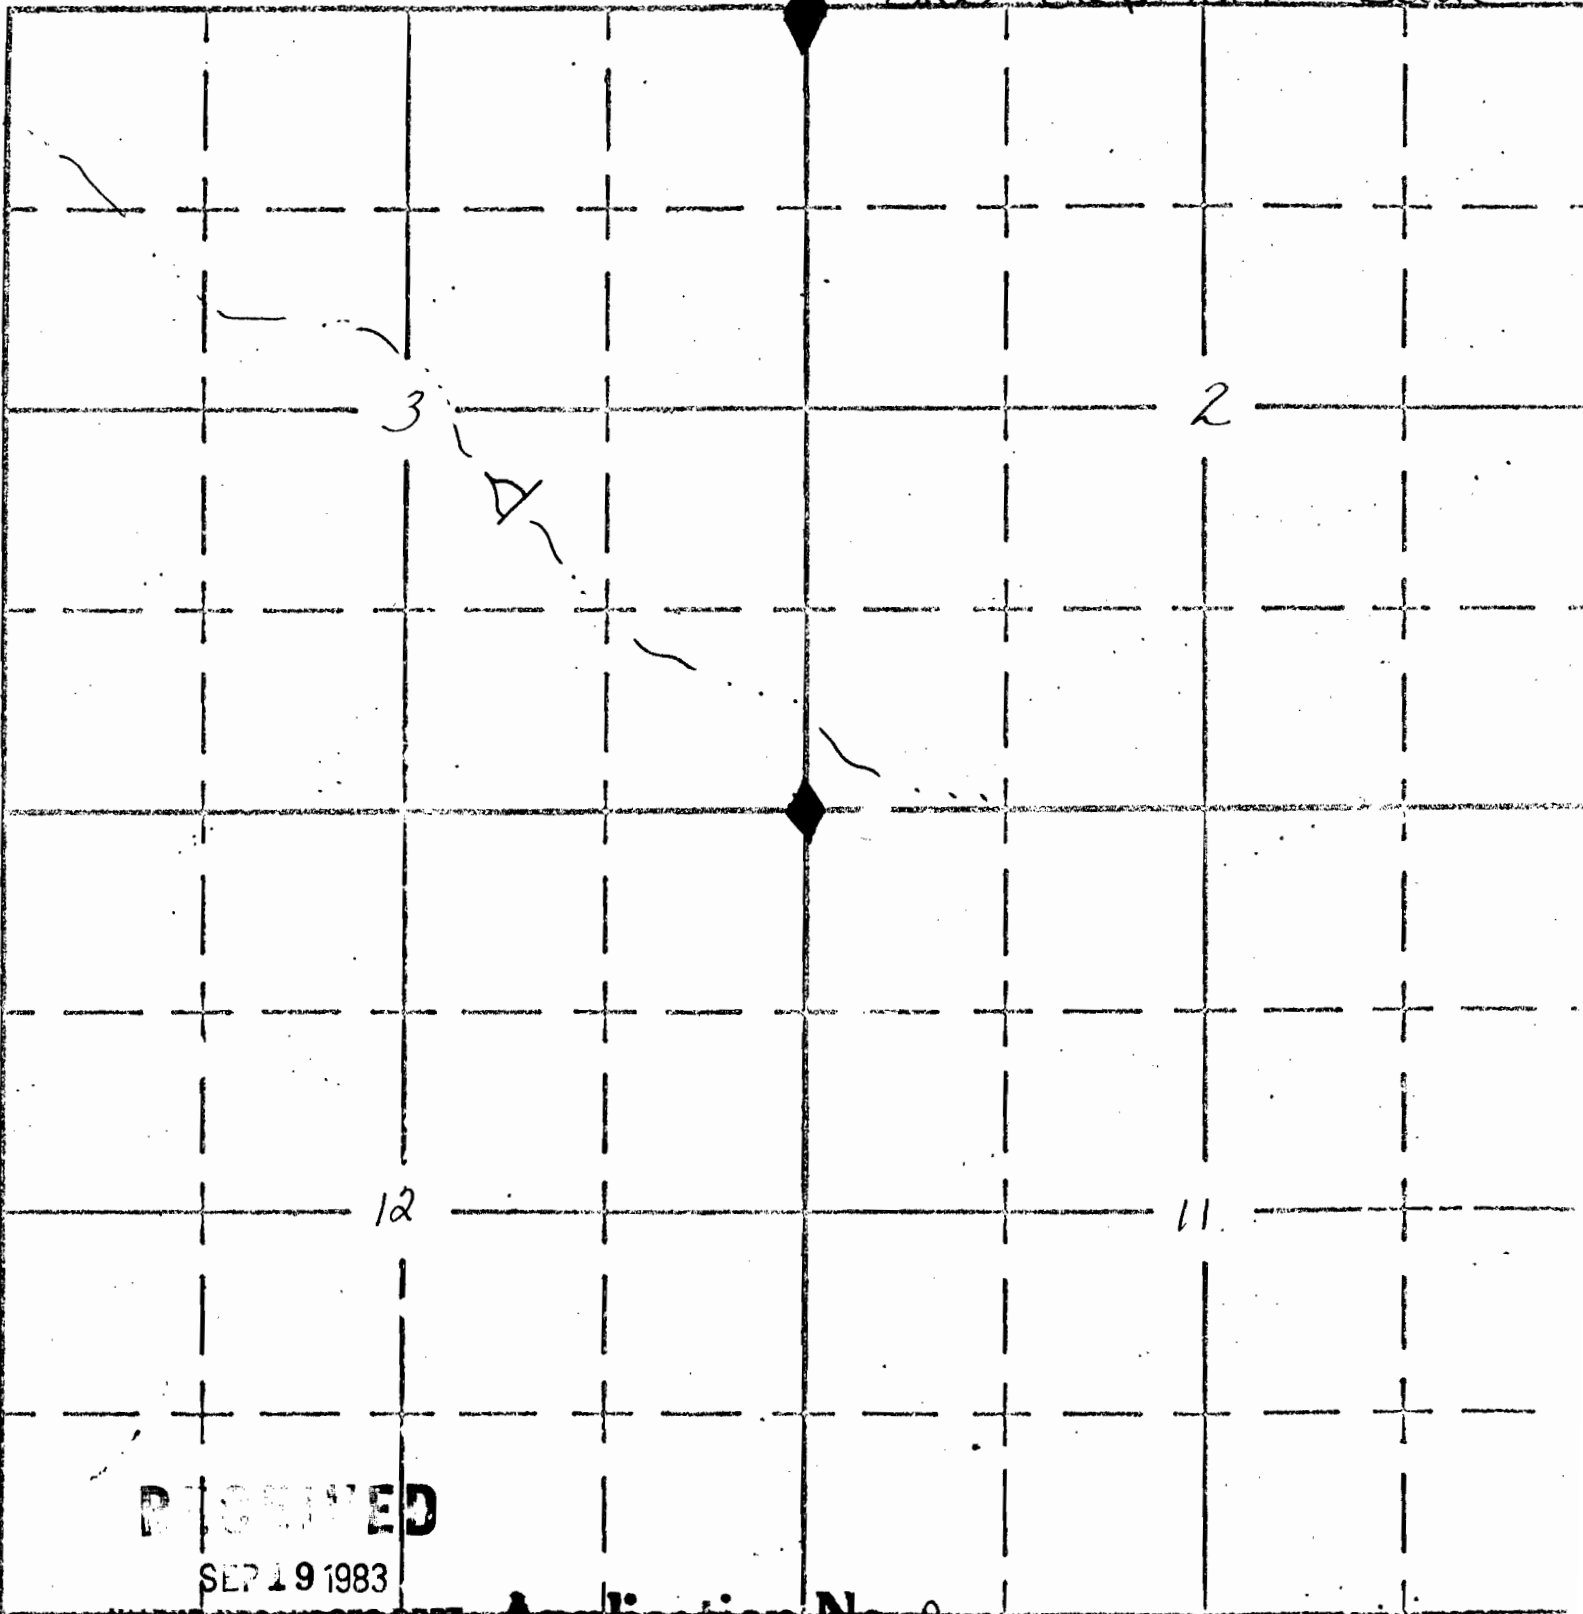

RECEIVED

SEP 19 1983

WATER RESOURCES DEPT.
SALEM, OREGON

Application No.

Permit No.

R-66196
R 9675

APPLICATION No.