


DEPARTMENT OF THE INTERIOR
BUREAU OF LAND MANAGEMENT

SECTION 3
NE SW

Oregon State Water Filings

TOWNSHIP 26 S, RANGE 34 E, W. M.

North 4694 Big Bull

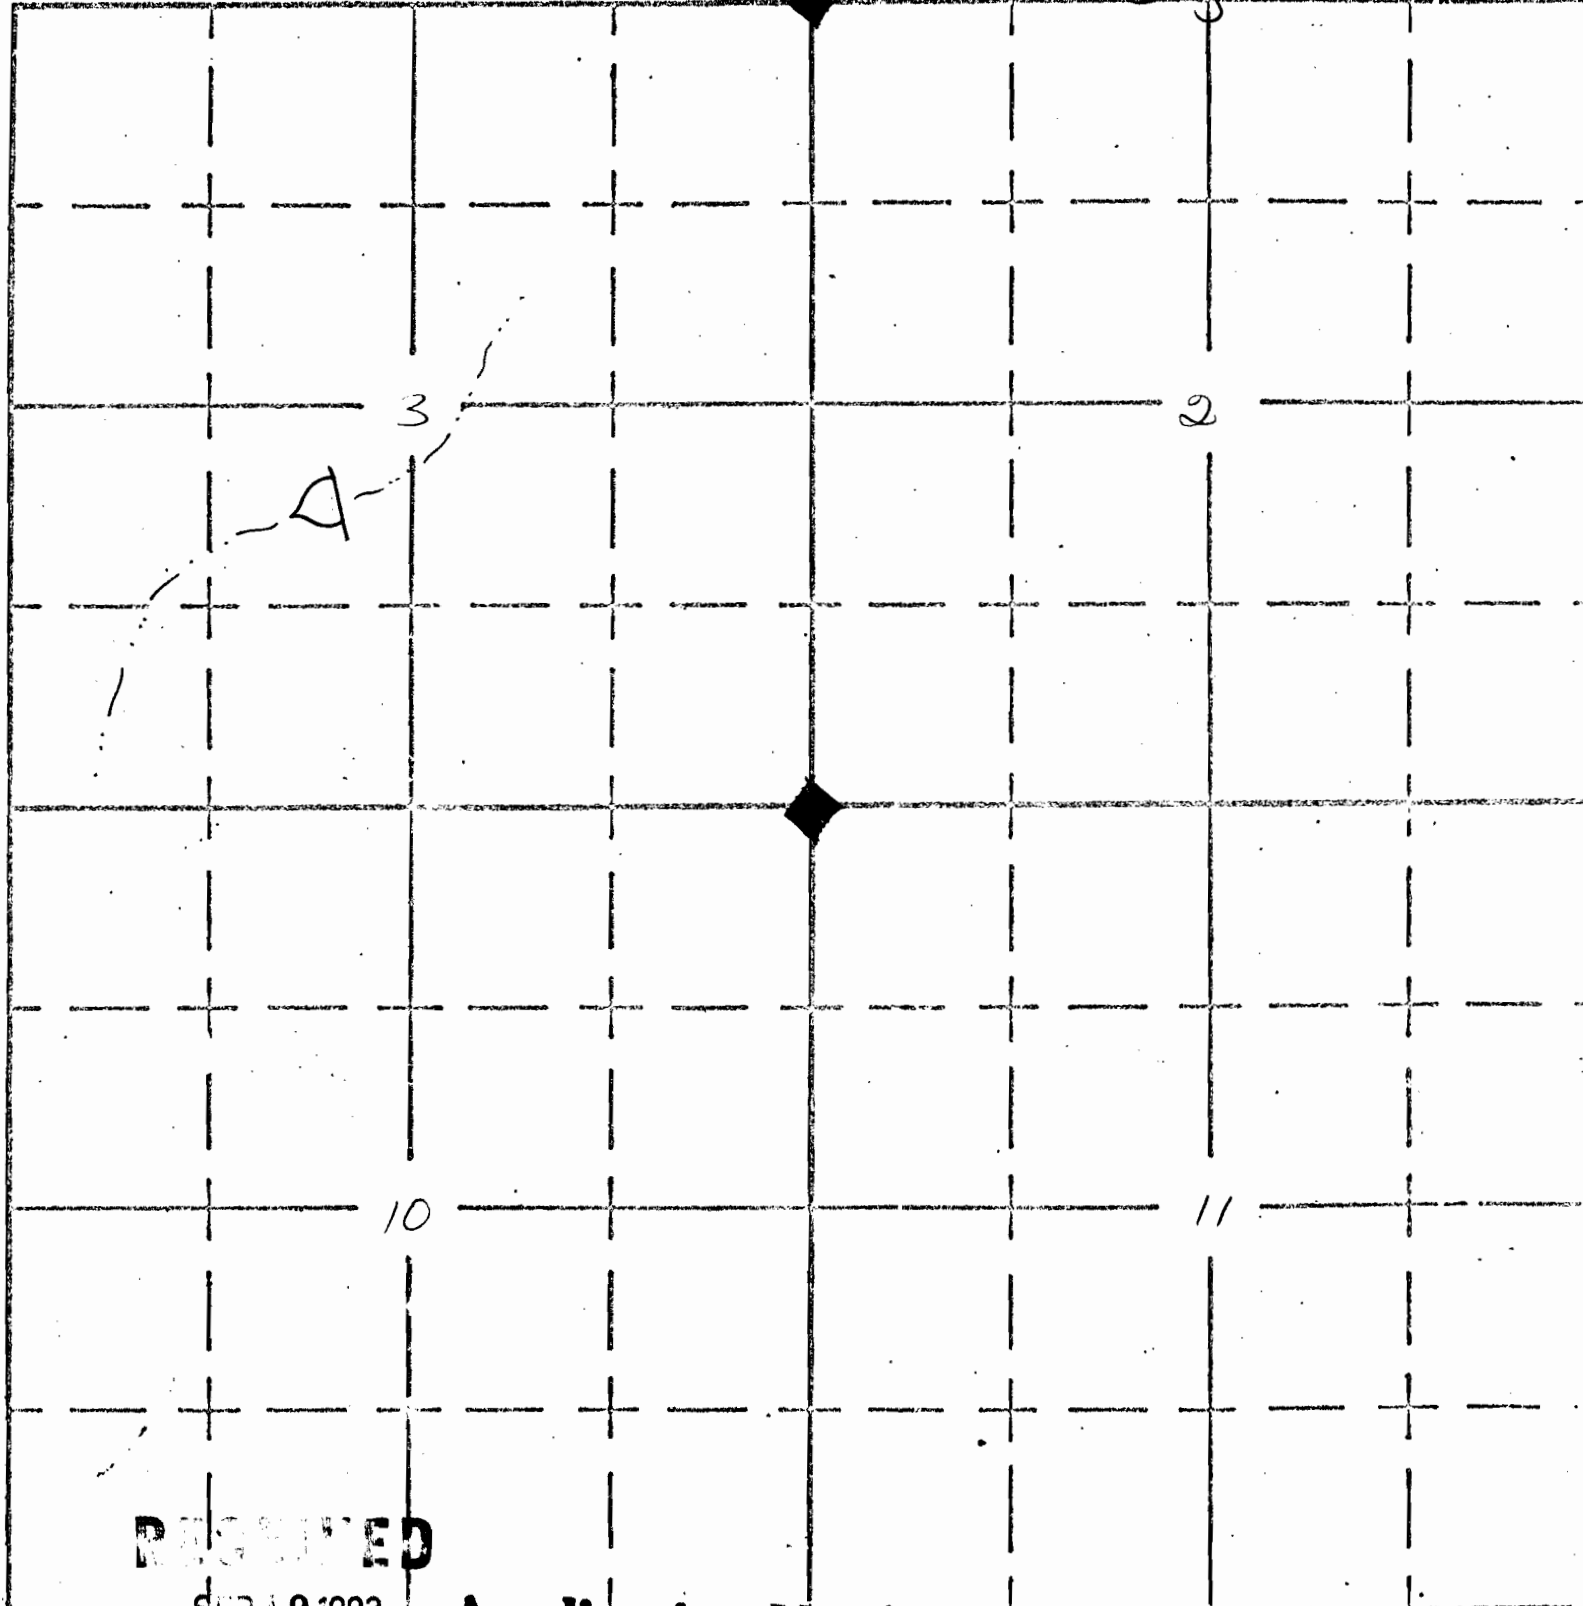

RECEIVED

SEP 19 1983

WATER RESOURCES DEPT.
SALEM, OREGON

Application No. R-666/98
Permit No. R 9677

APPLICATION No.