

DEPARTMENT OF THE INTERIOR
BUREAU OF LAND MANAGEMENT

SECTION 12


Oregon State Water Filings

NE 1/4 NW 1/4

TOWNSHIP 26S, RANGE 34E, W. M.

North

4798 Pronghorn

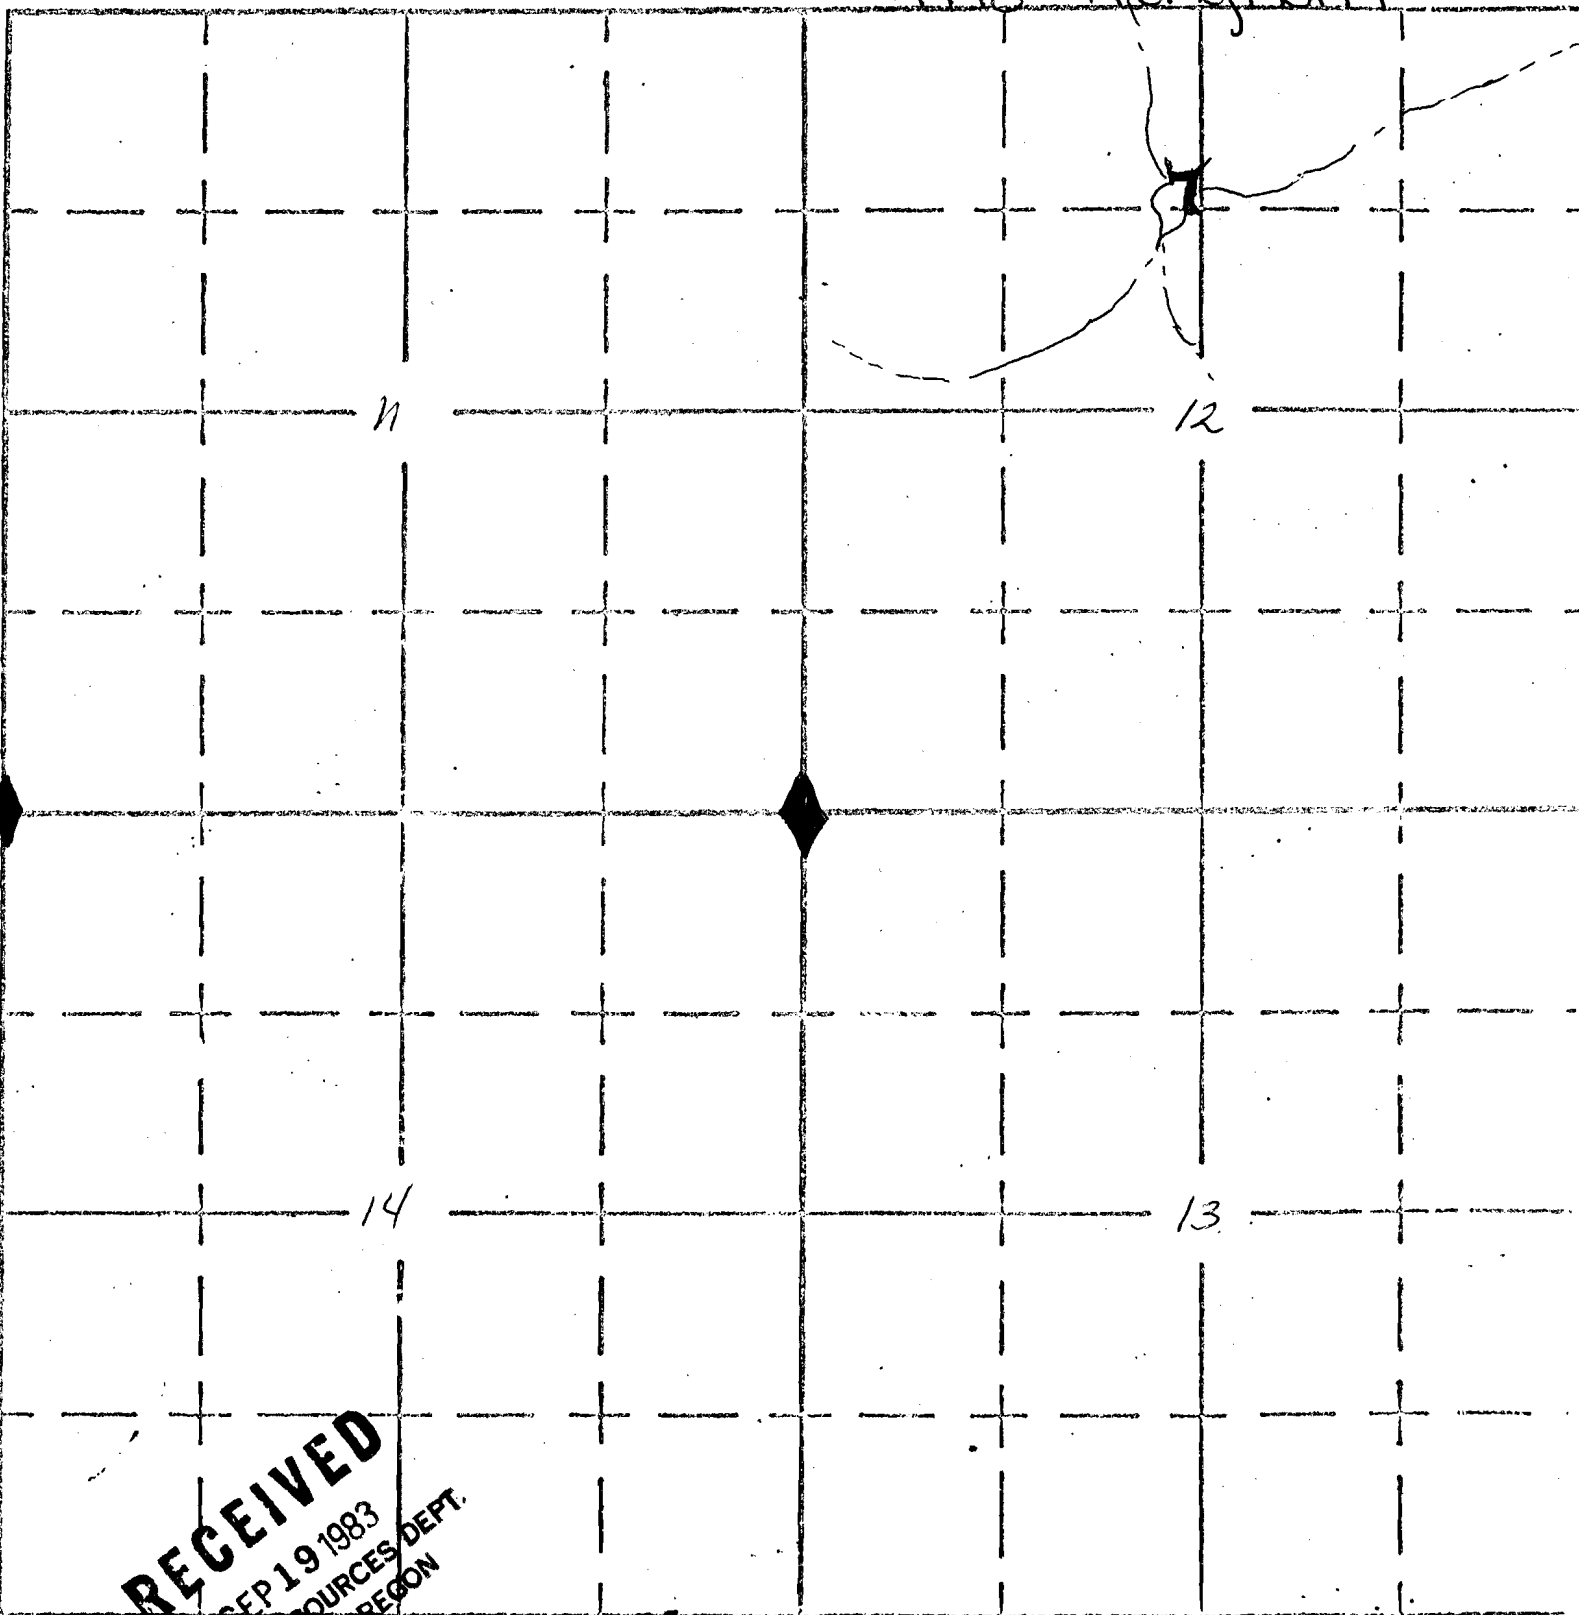

RECEIVED
SEP 19 1983
WATER RESOURCES DEPT.
SALEM OREGON

Application No.

Permit No.

R 9746

Source R-662411

APPLICATION No.