

UNITED STATES
DEPARTMENT OF THE INTERIOR
BUREAU OF LAND MANAGEMENT


SECTION 2

Oregon State Water Filings

NE 1/4 NW 1/4

TOWNSHIP 24 S, RANGE 34 E, W. M.

North Rhomboid 4655

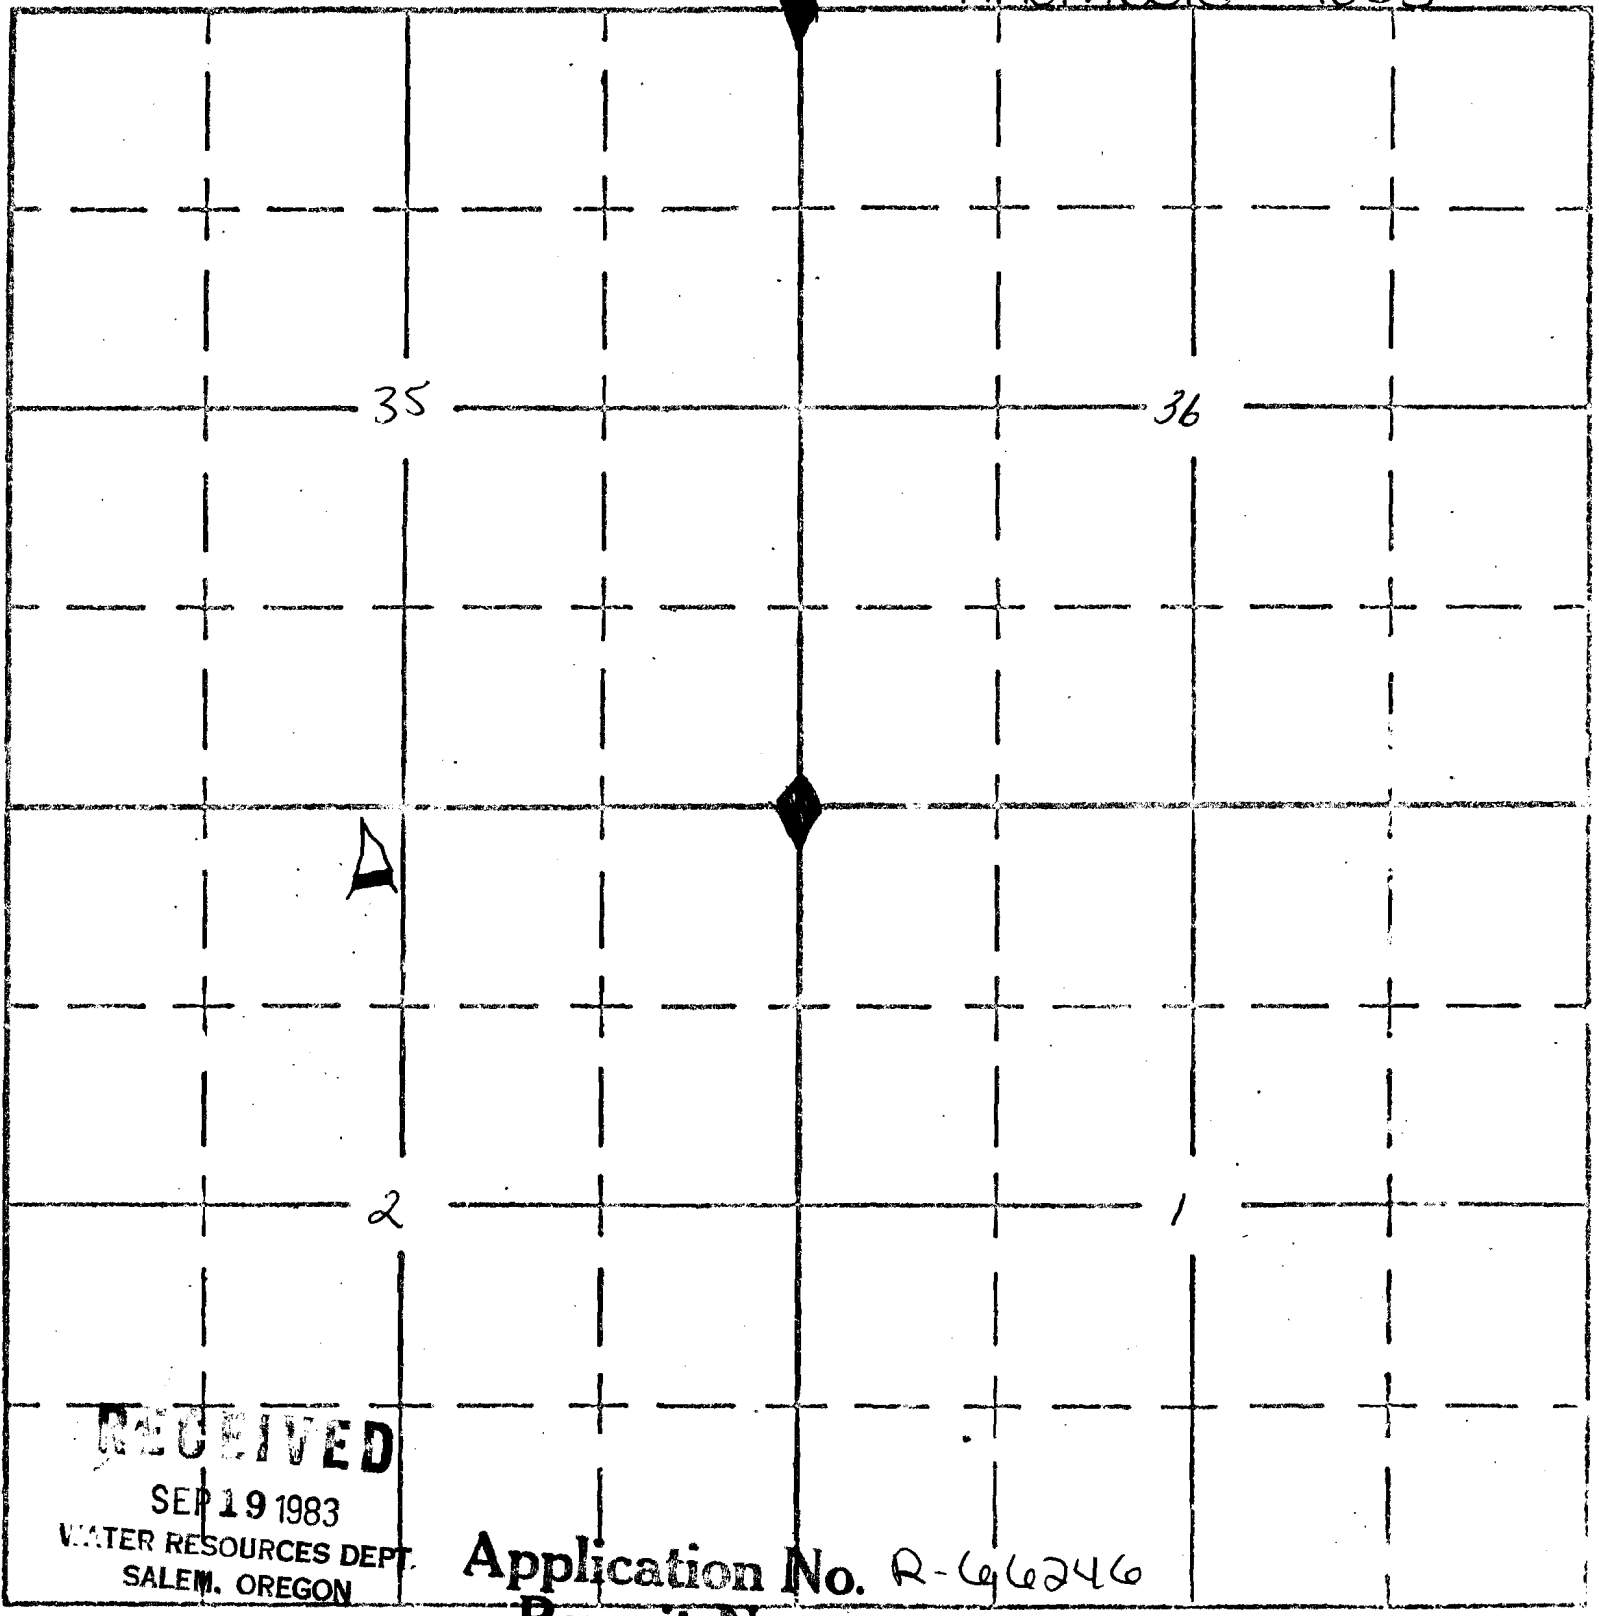

RECEIVED
SEP 19 1983
WATER RESOURCES DEPT.
SALEM, OREGON

Permit No. R 9751

APPLICATION NO.