


UNITED STATES
DEPARTMENT OF THE INTERIOR
BUREAU OF LAND MANAGEMENT

SECTION 9

Oregon State Water Filings

NW 1/4 NE 1/4

TOWNSHIP 22S, RANGE 34E, W. M.

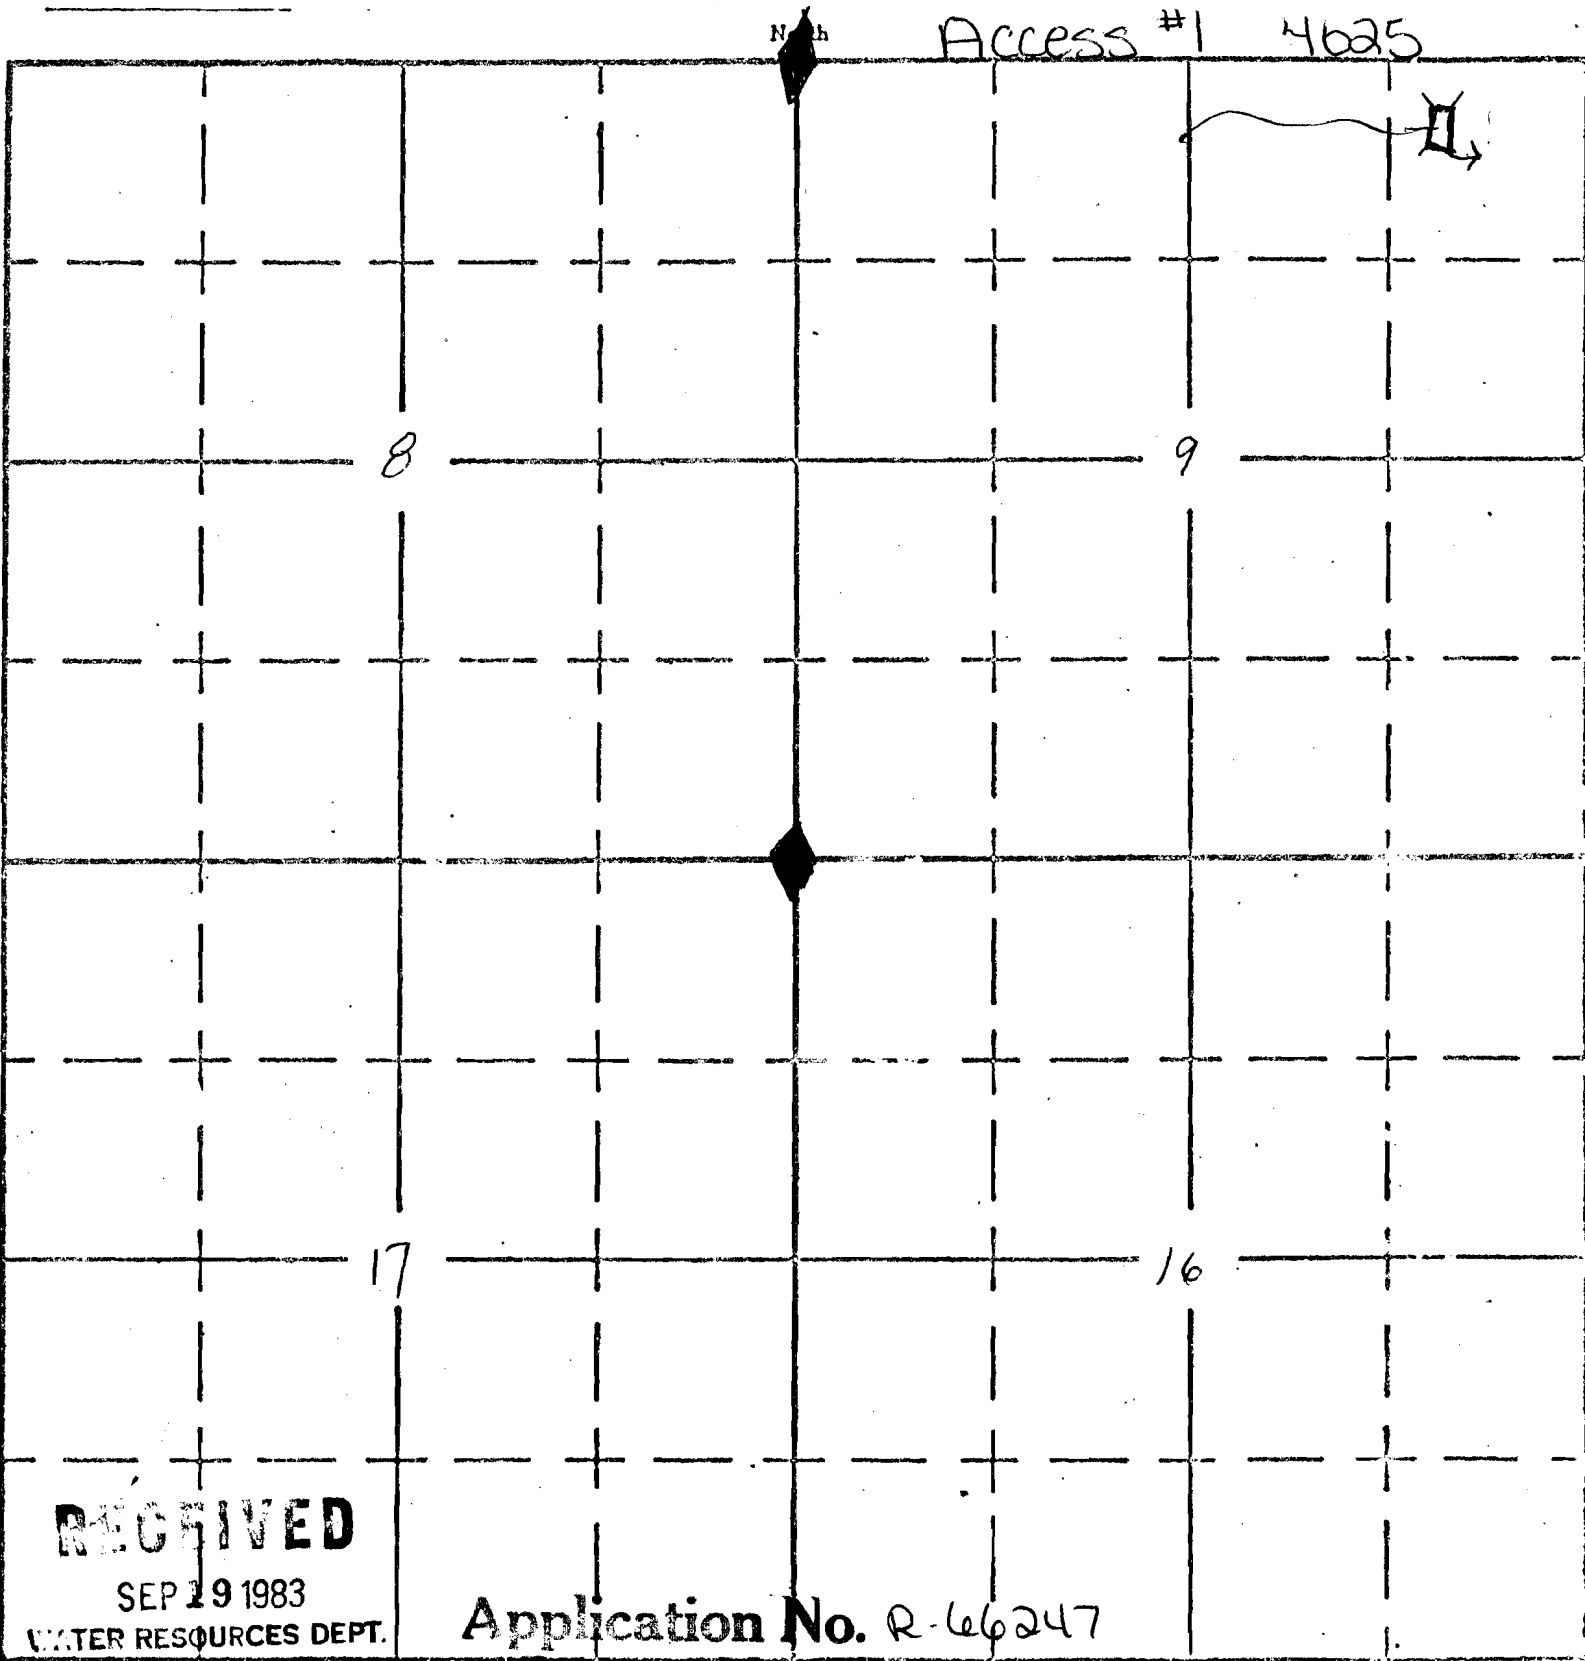

RECEIVED

SEP 19 1983

WATER RESOURCES DEPT.
SALEM, OREGON

Application No. R-66247

Permit No. R 9752

APPLICATION No.