


SECTION 4
NE NW

5359 - Seepy Spr. Res.

TOWNSHIP 29 S, RANGE 37 E, W. M.

North

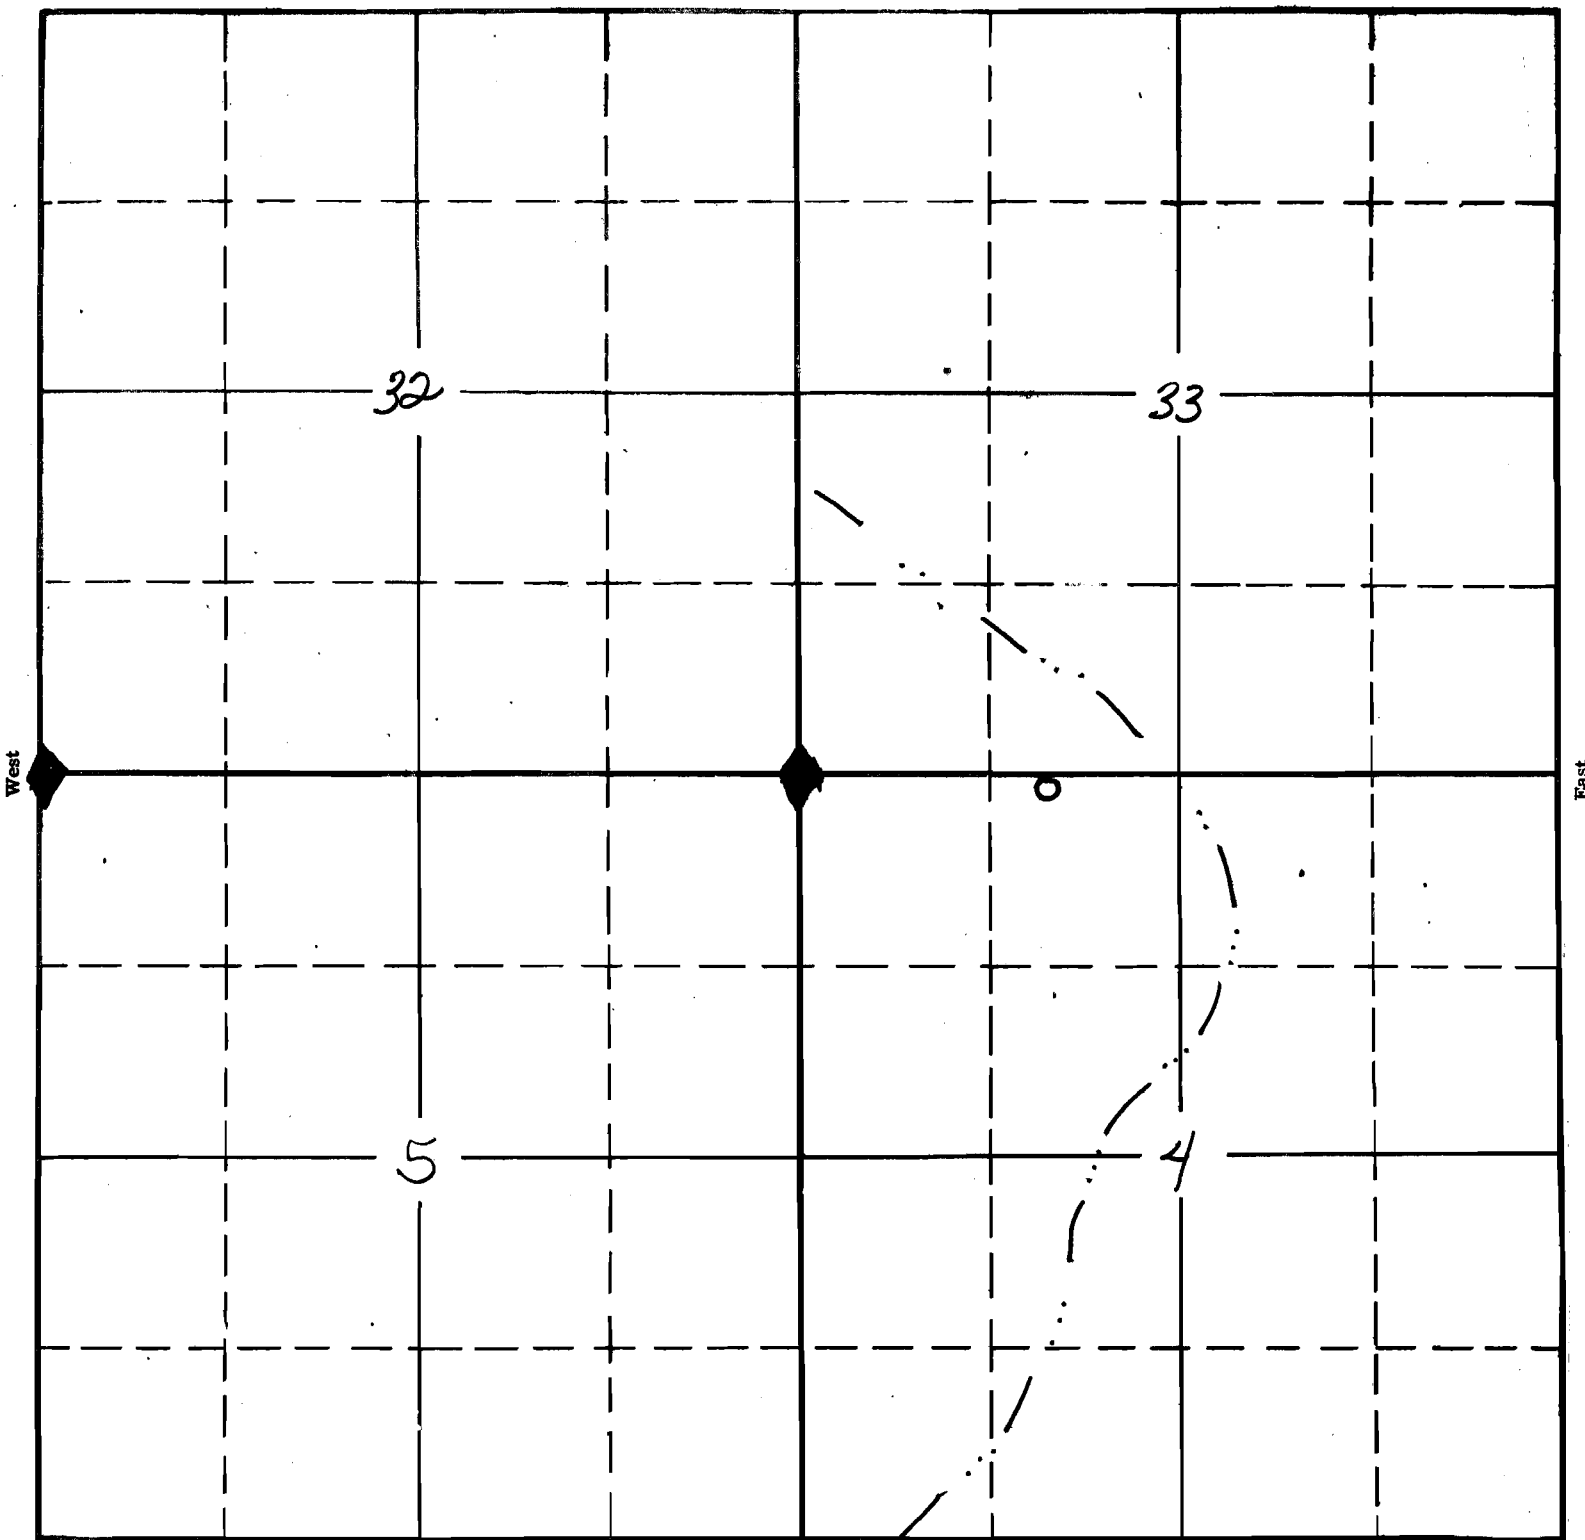

South

RECEIVED

SEP 19 1983
WATER RESOURCES DEPT.
SALEM, OREGON

Application No. R-66254
Permit No. R 9759

APPLICATION No.
PERMIT No.