


SW NE

TOWNSHIP 21S, RANGE 33E, W. M.

North

Jeep Trail Res.

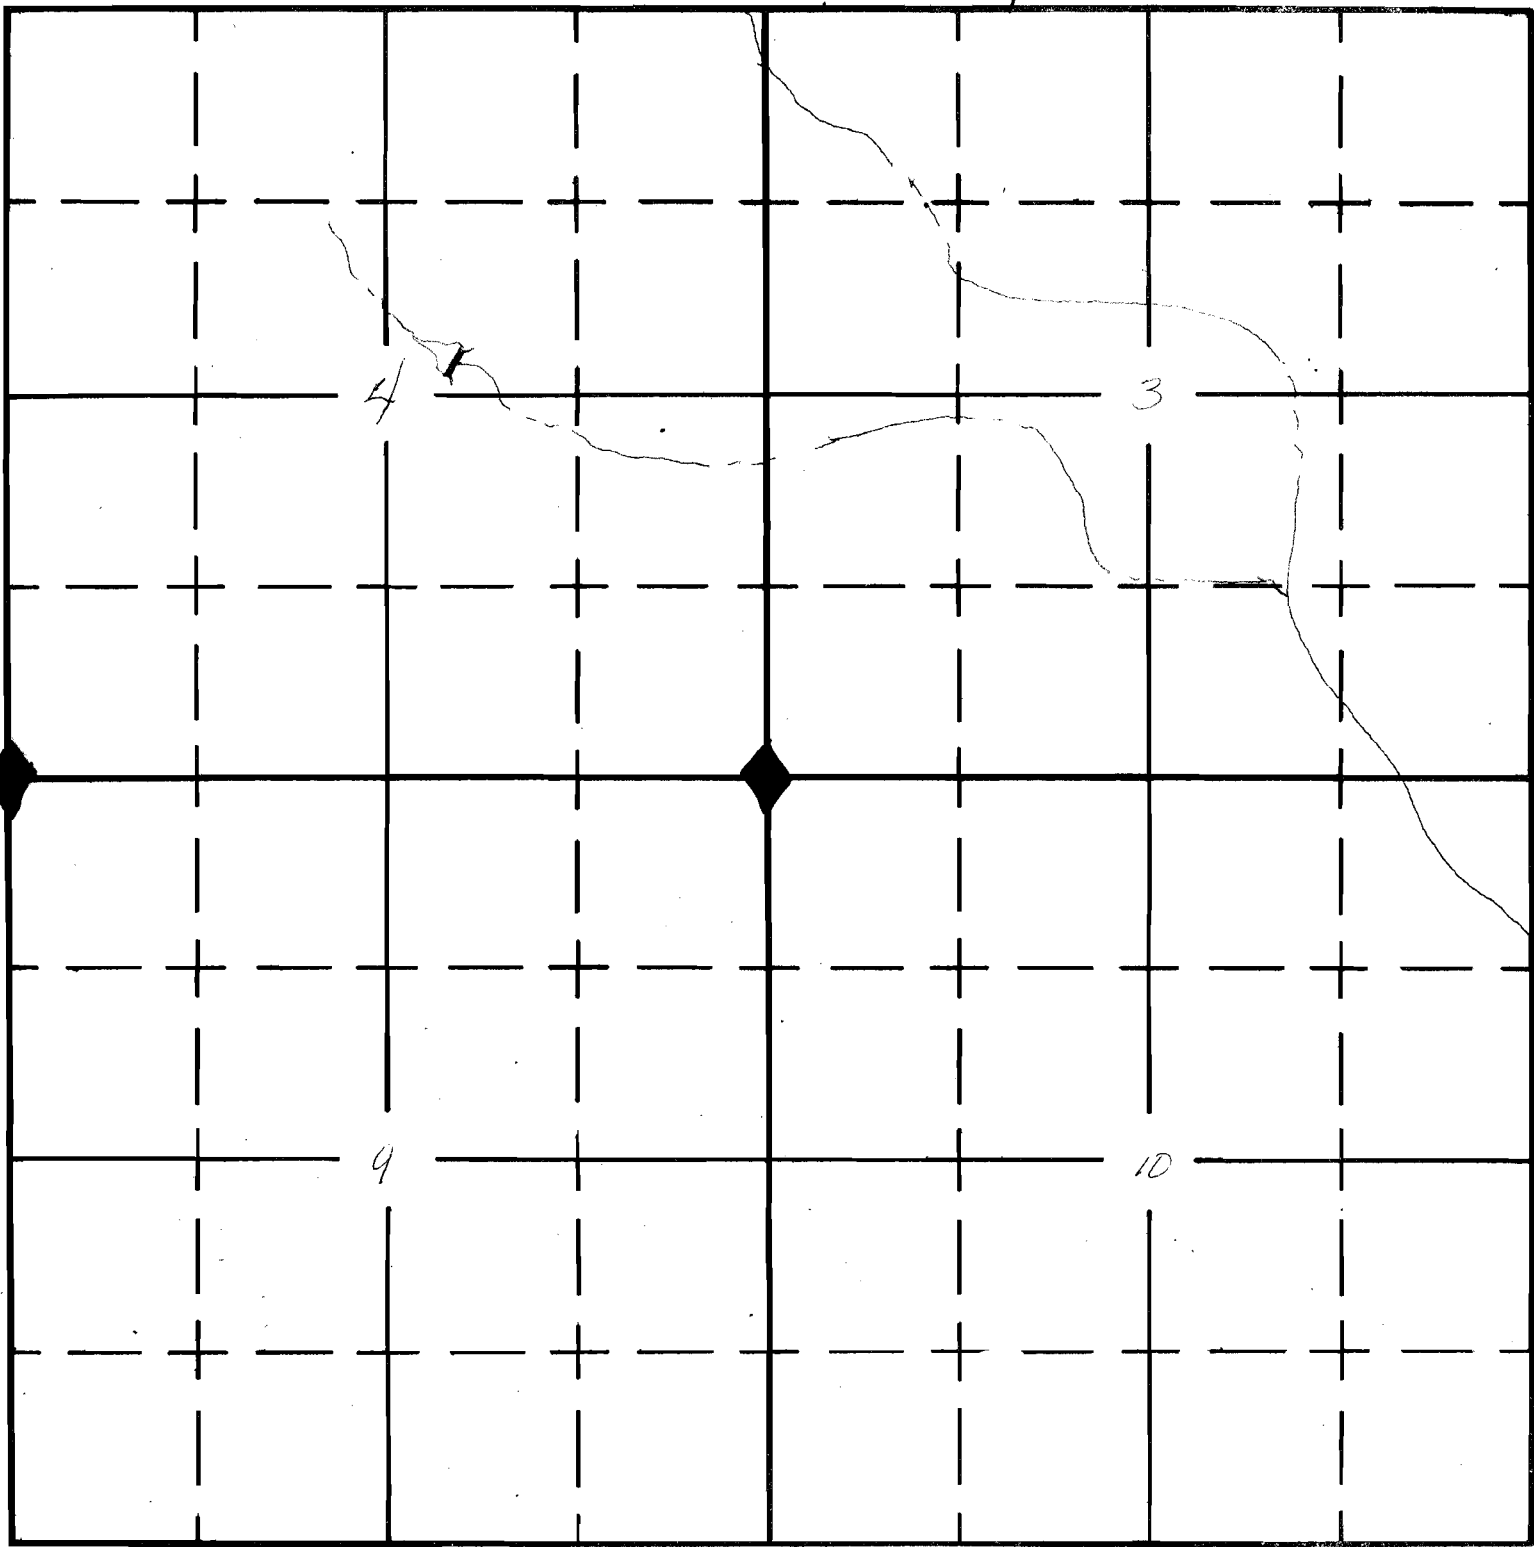

East

South

RECEIVED

SEP 19 1983
WATER RESOURCES DEPT.
SALEM, OREGON

Application No. R-66286
Permit No. R 9761