


SECTION 29

SE NW

TOWNSHIP 22S, RANGE 34E, W. M.

North

Crazyman Res.

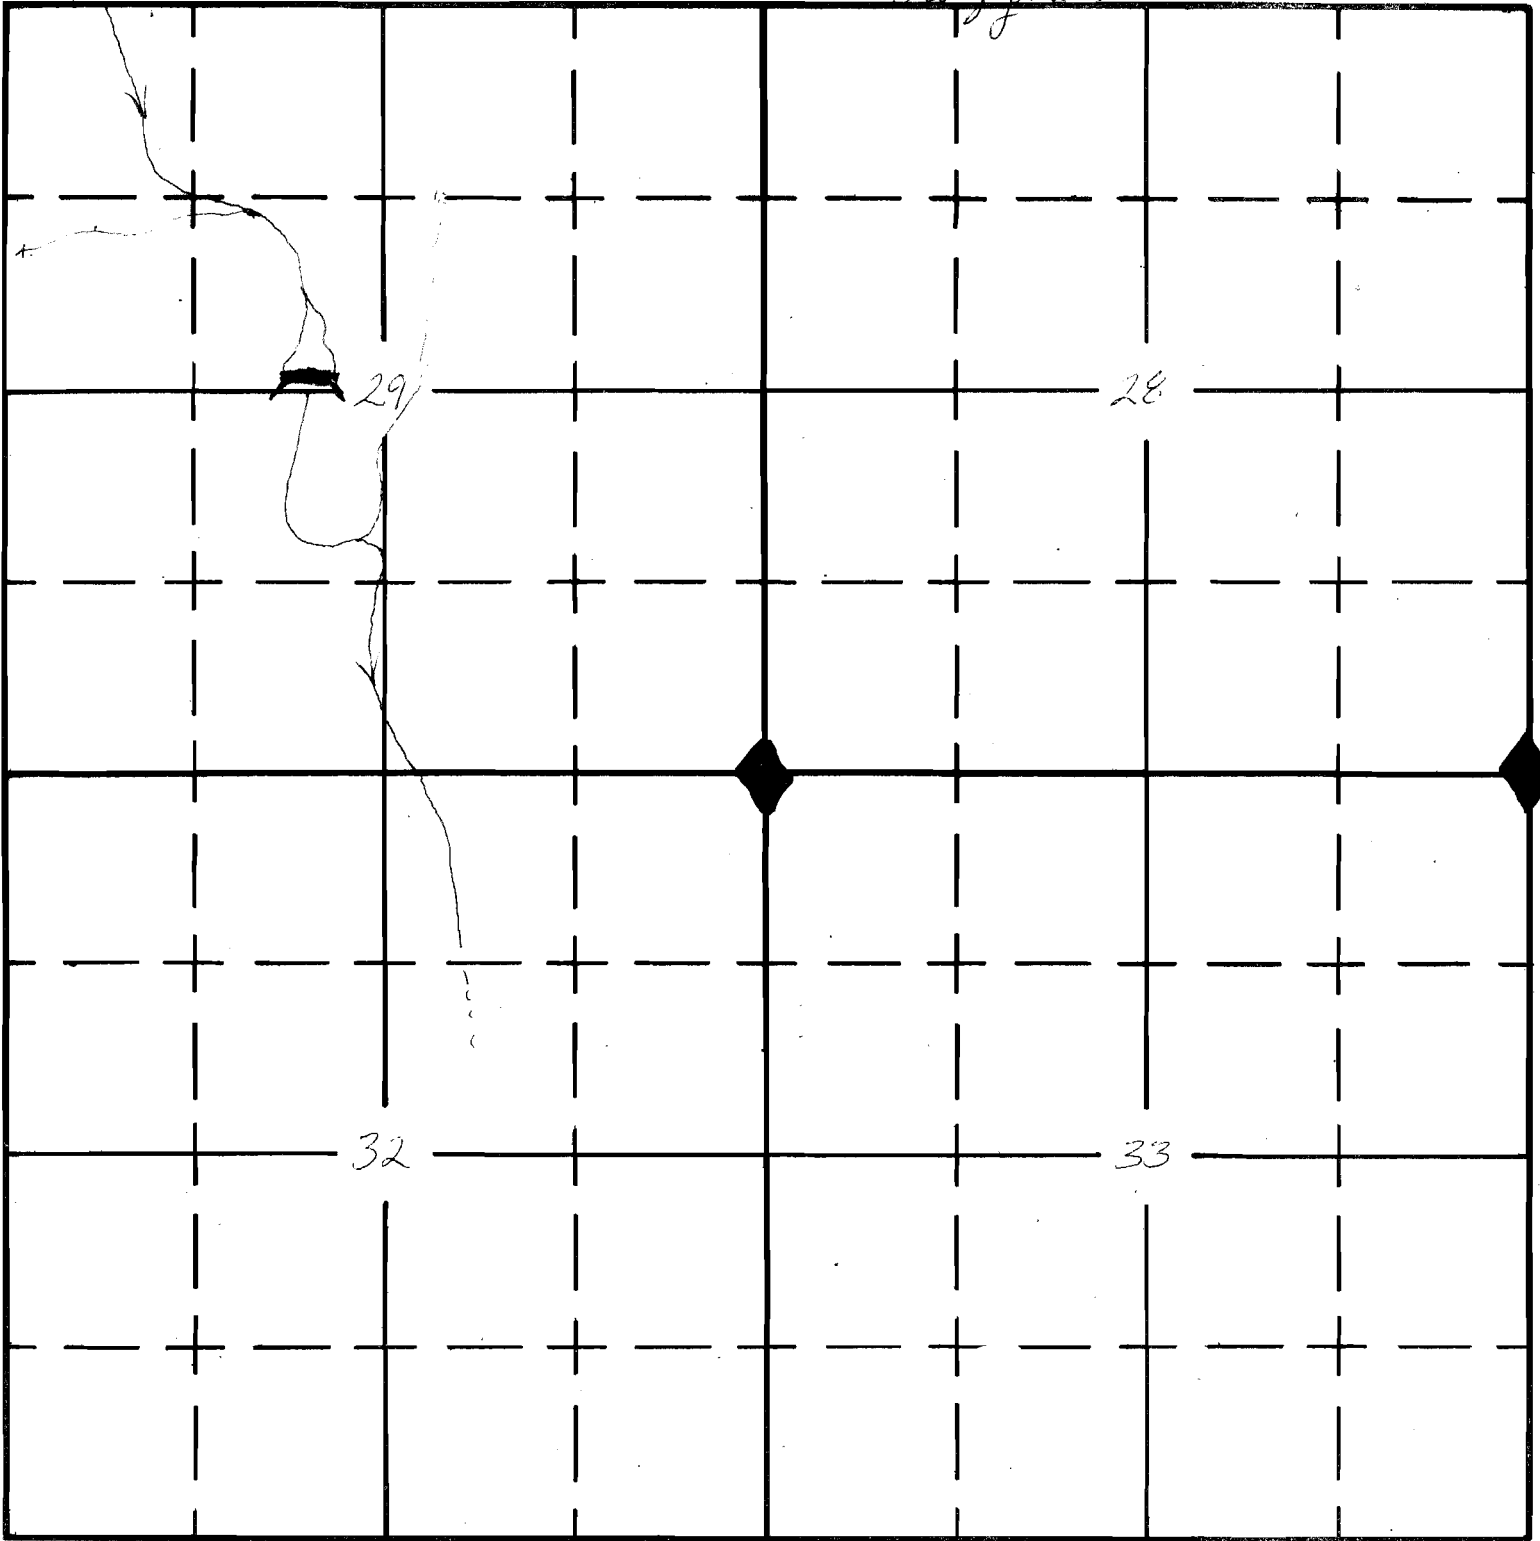

South

RECEIVED

SEP 19 1983
WATER RESOURCES DEPT.
SALEM, OREGON

Application No. R-66258
Permit No. R 9763