


SECTION 7

SW NE

TOWNSHIP 19 S, RANGE 35 E, W. M.

North

Running Dog

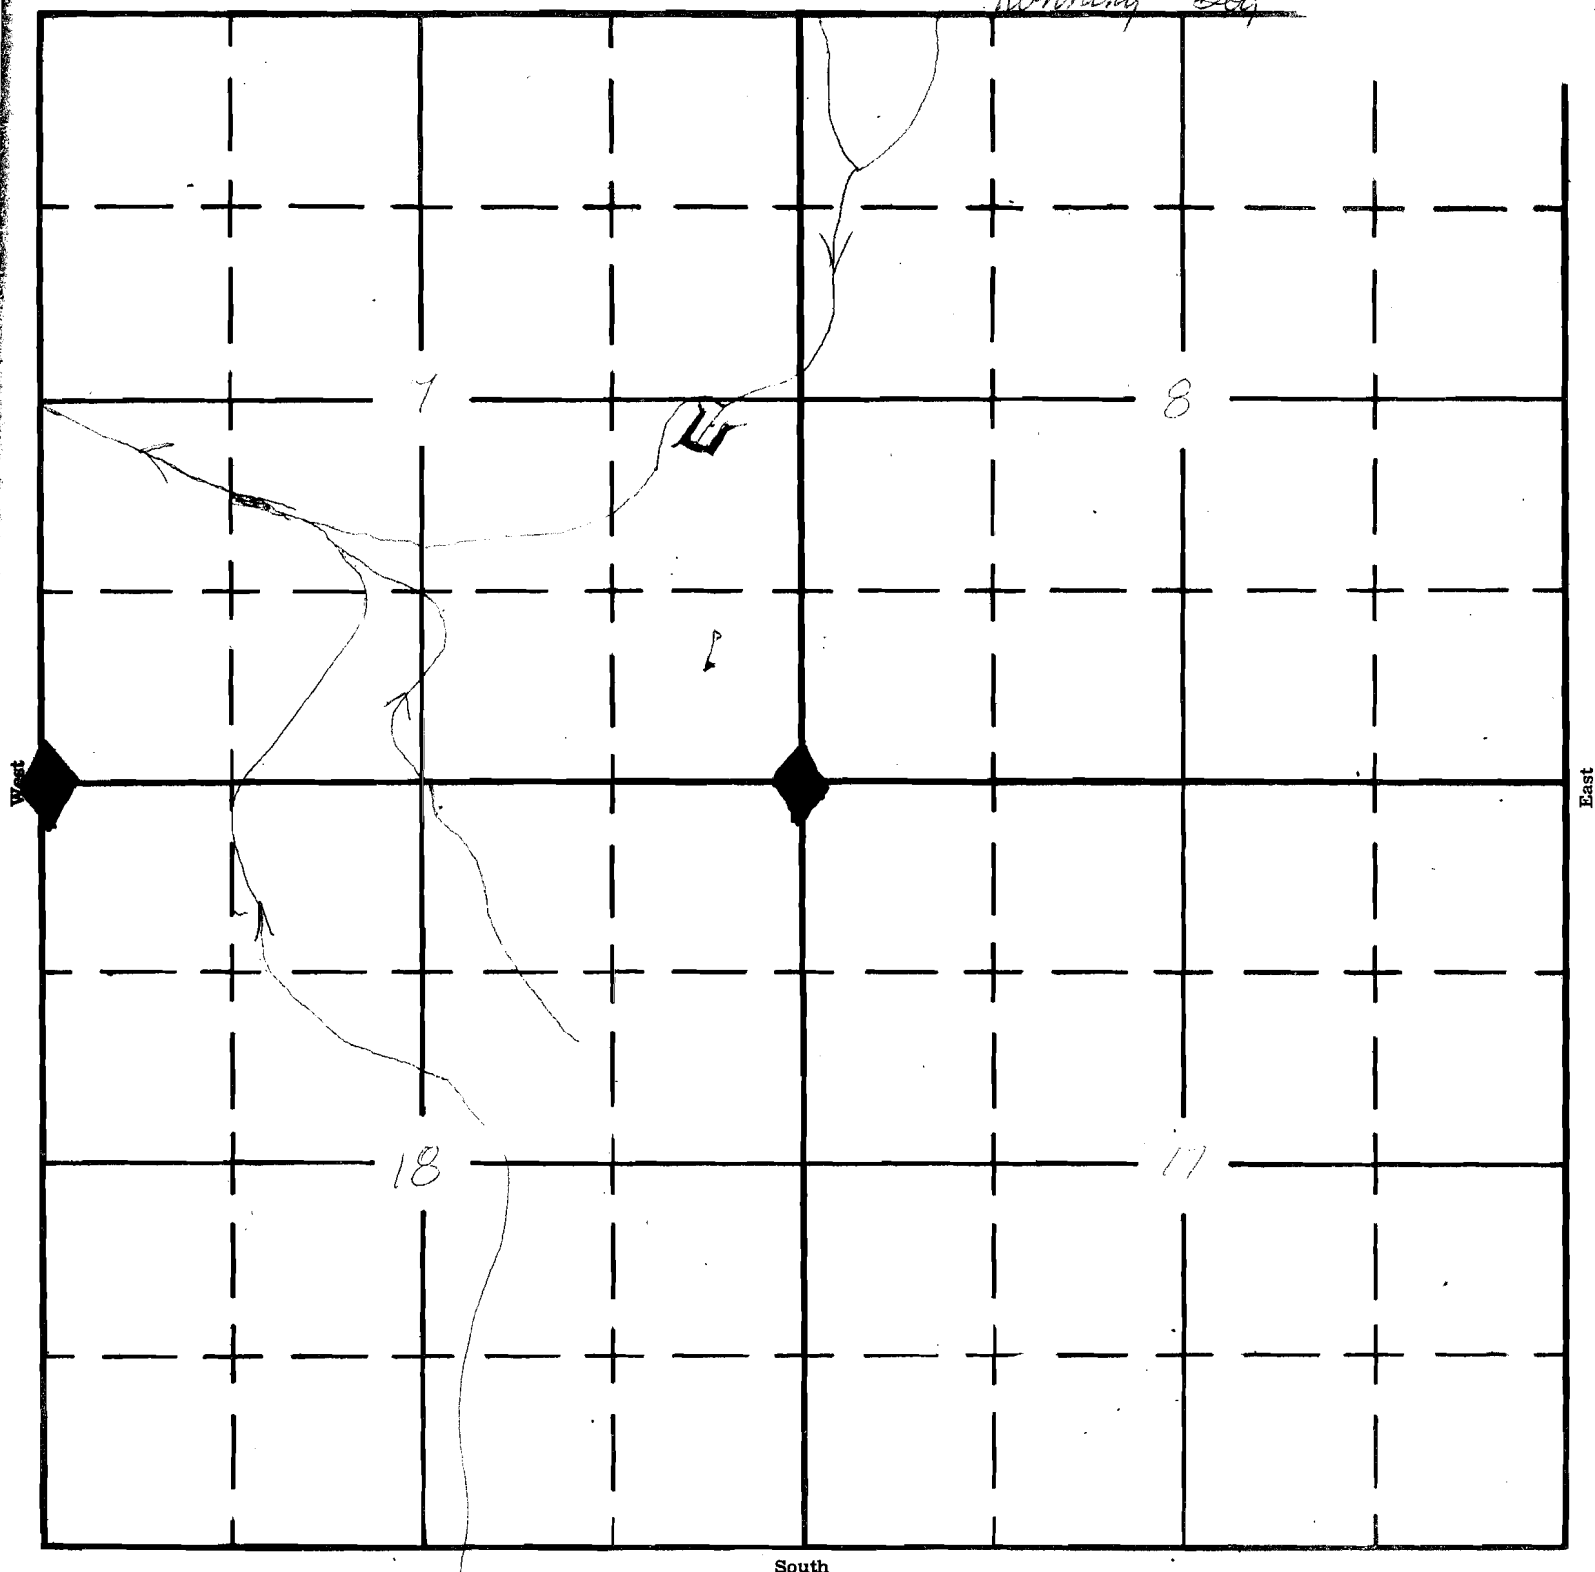

RECEIVED

SEP 19 1983

WATER RESOURCES DEPT.
SALEM, OREGON

Application No. R-66259
Permit No. R 9764