


SECTION

28 SW NE

TOWNSHIP 22 S, RANGE 24 E, W. M.

North #0294-Bulger WTI

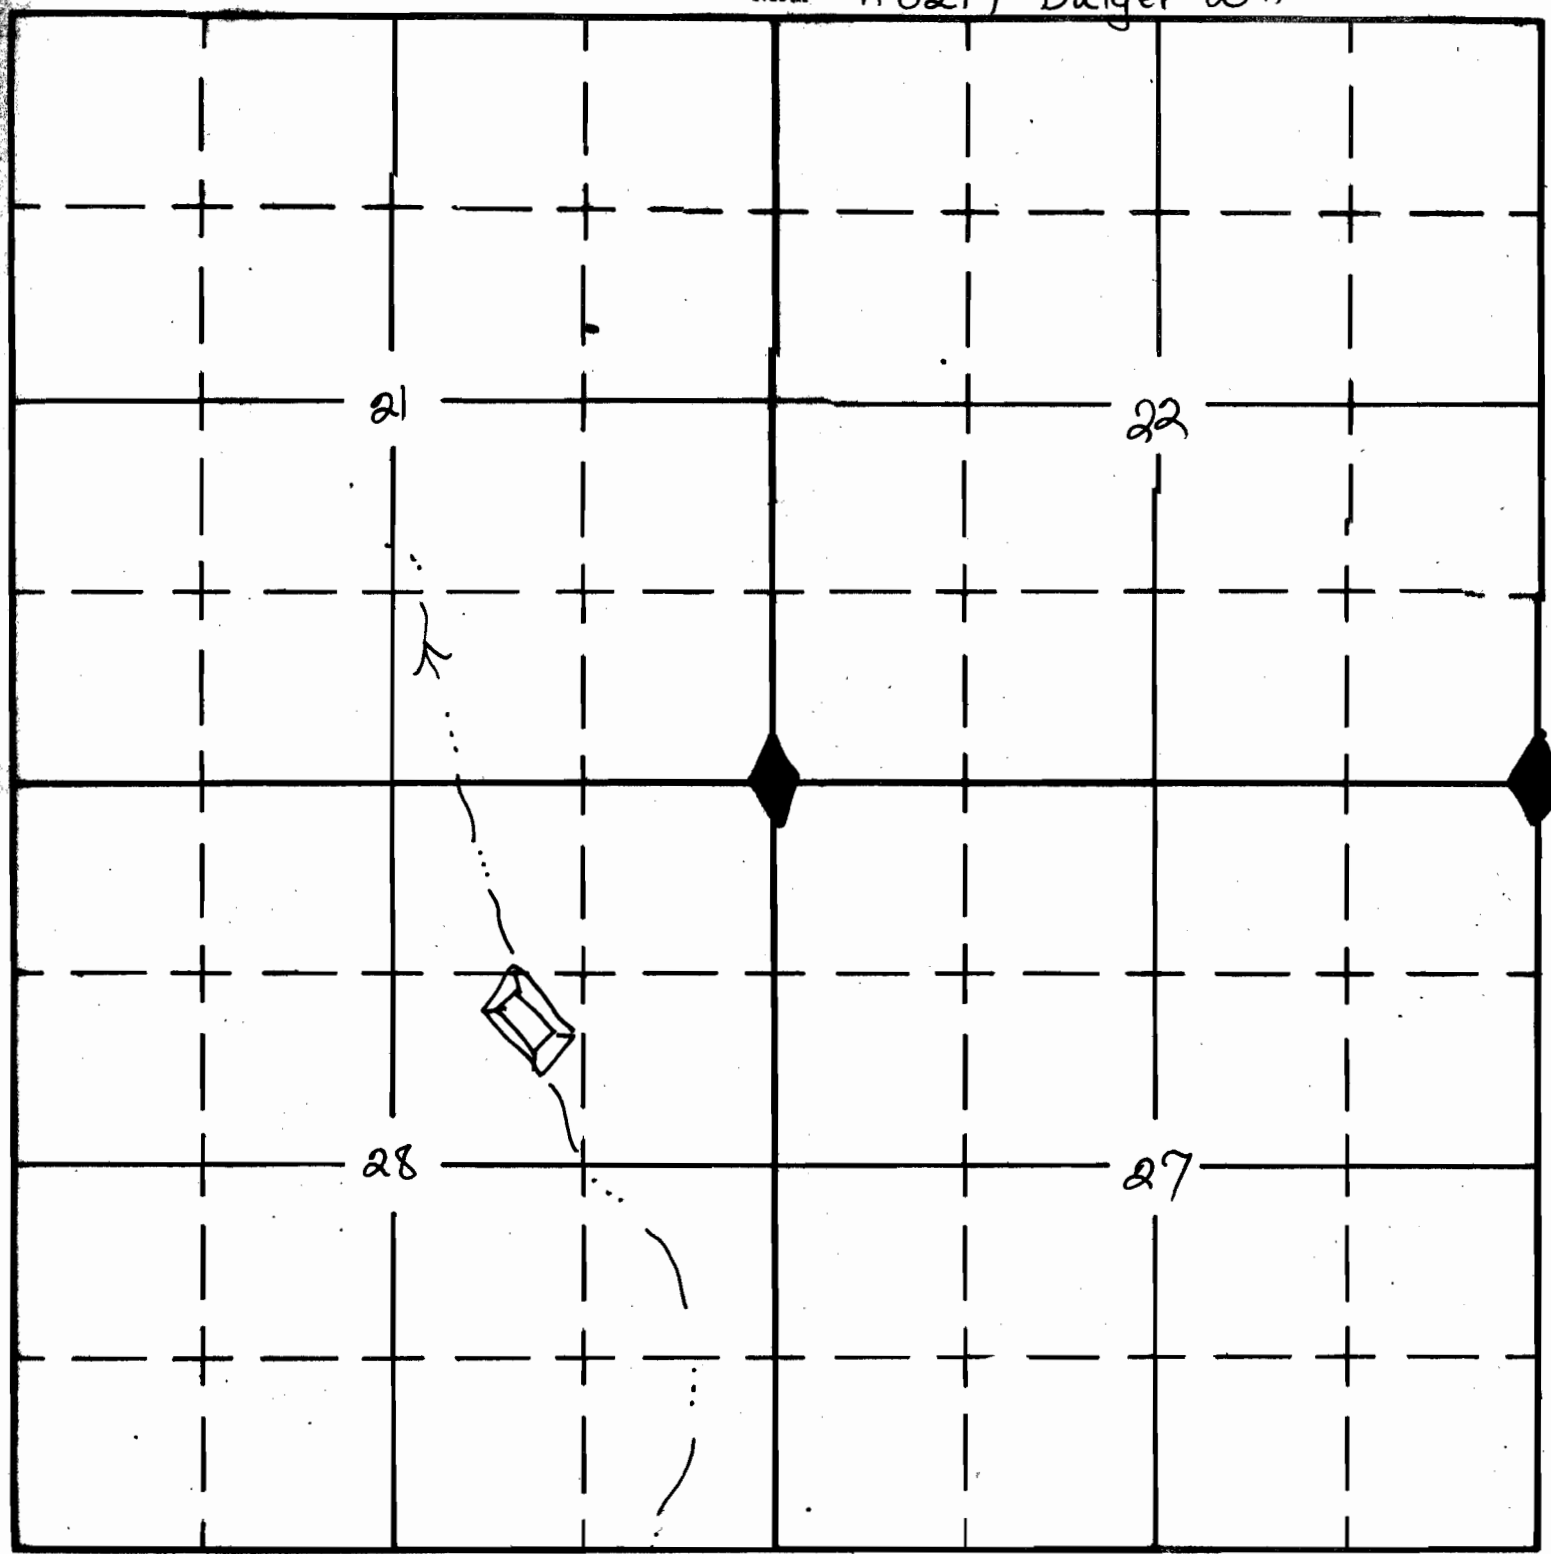

South

RECEIVED

SEP 19 1983

LAND RESOURCES DEPT.
SALEM, OREGON

Application No. R-66269
Permit No. R 9774