


DEPARTMENT OF THE INTERIOR
BUREAU OF LAND MANAGEMENT

SECTION 32
NW 1/4 SE 1/4

Oregon State Water Filings

TOWNSHIP 23 S, RANGE 36 E, W. M.

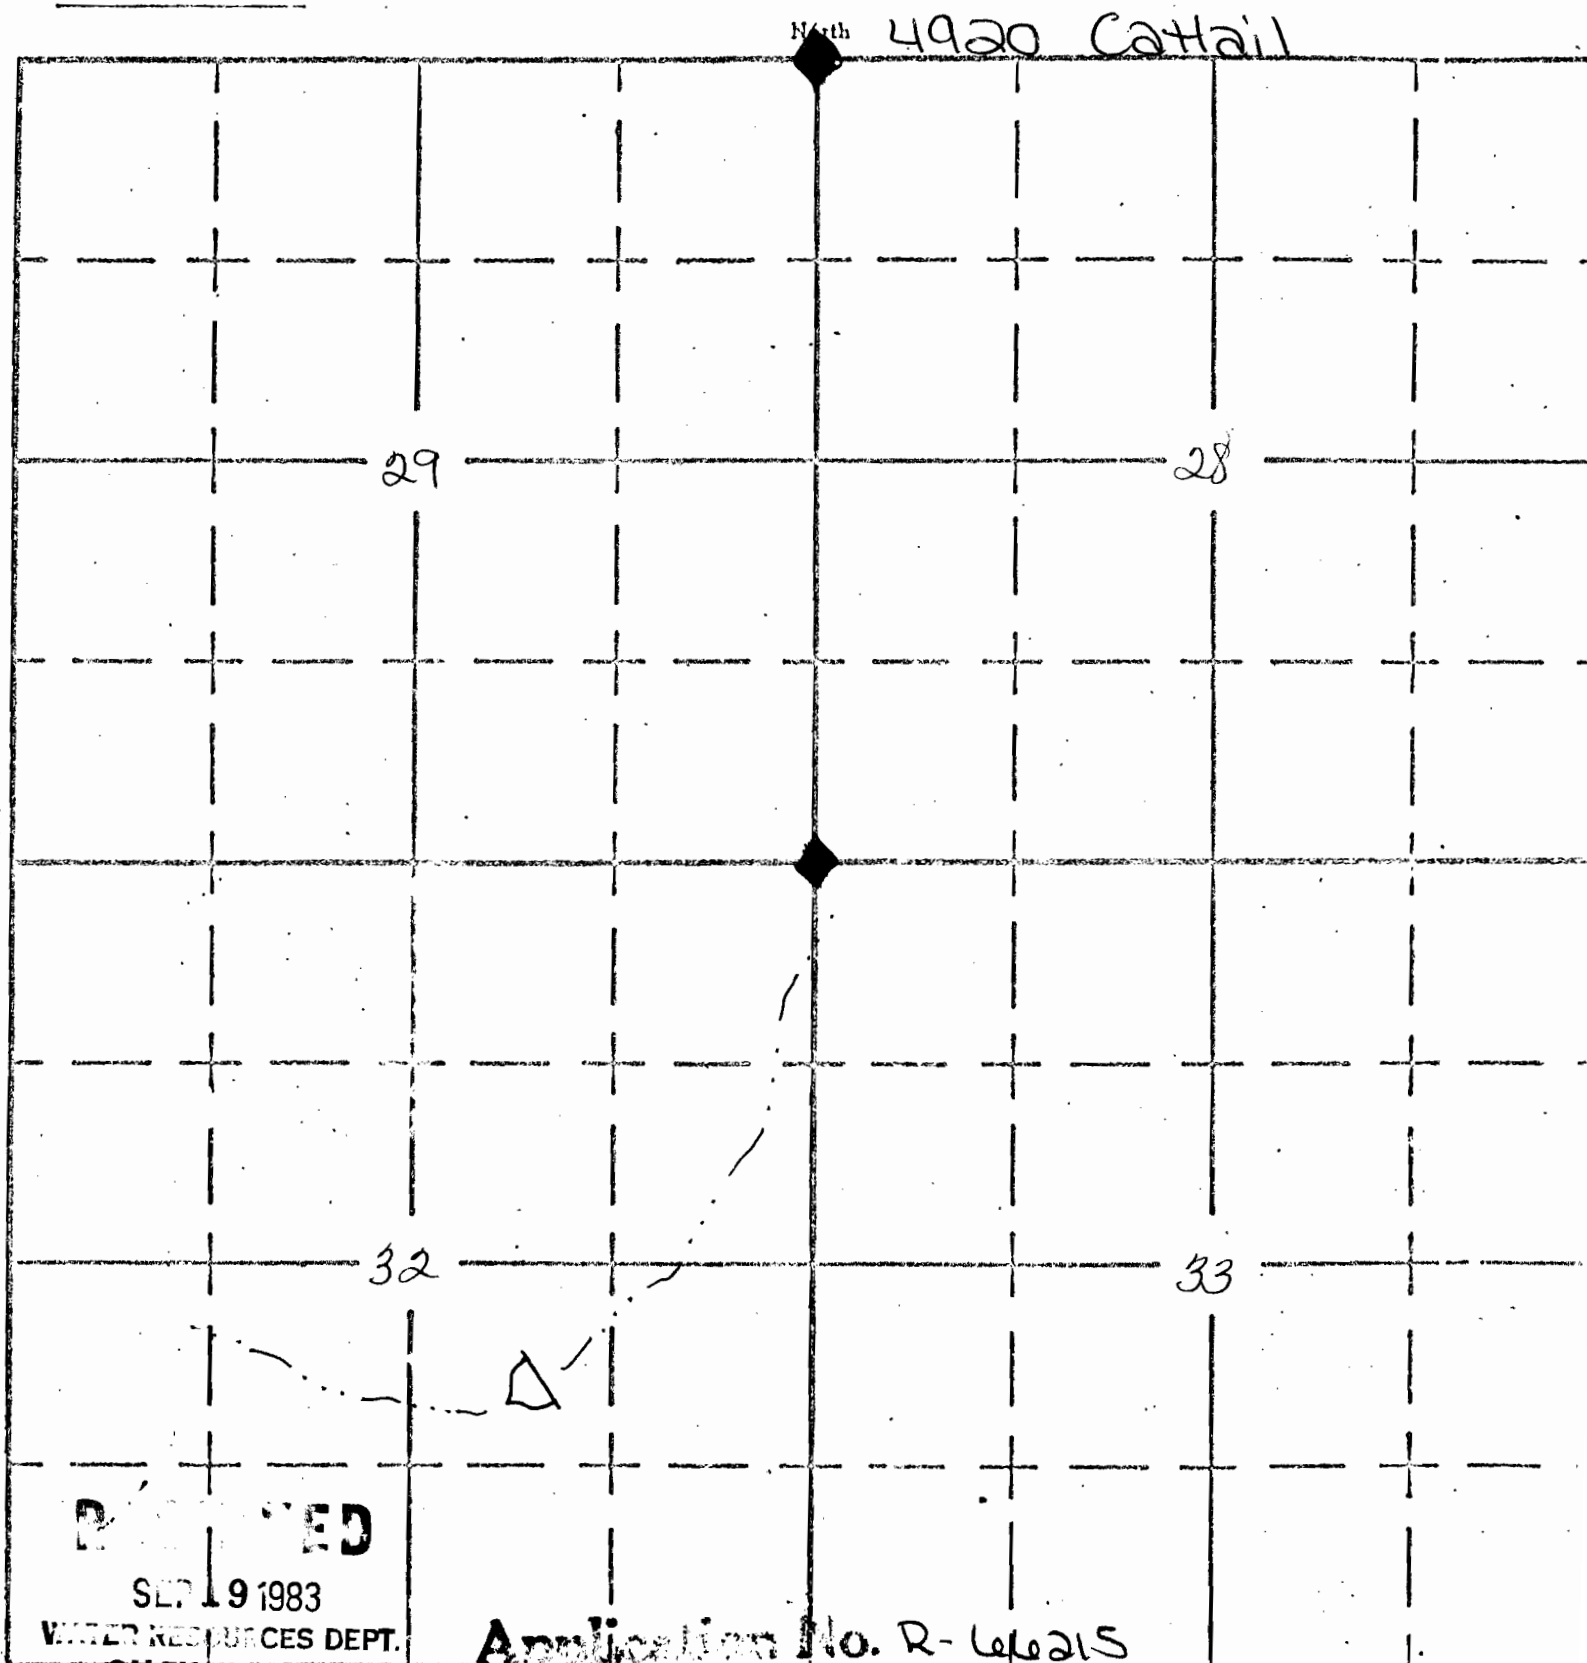

Form No. R 9786

APPLICATION No.