

DEPARTMENT OF THE INTERIOR
BUREAU OF LAND MANAGEMENT

SECTION


9 SW NE

Oregon State Water Filings

TOWNSHIP 22 S, RANGE 34 E, W. M.

North

4626 Access #2

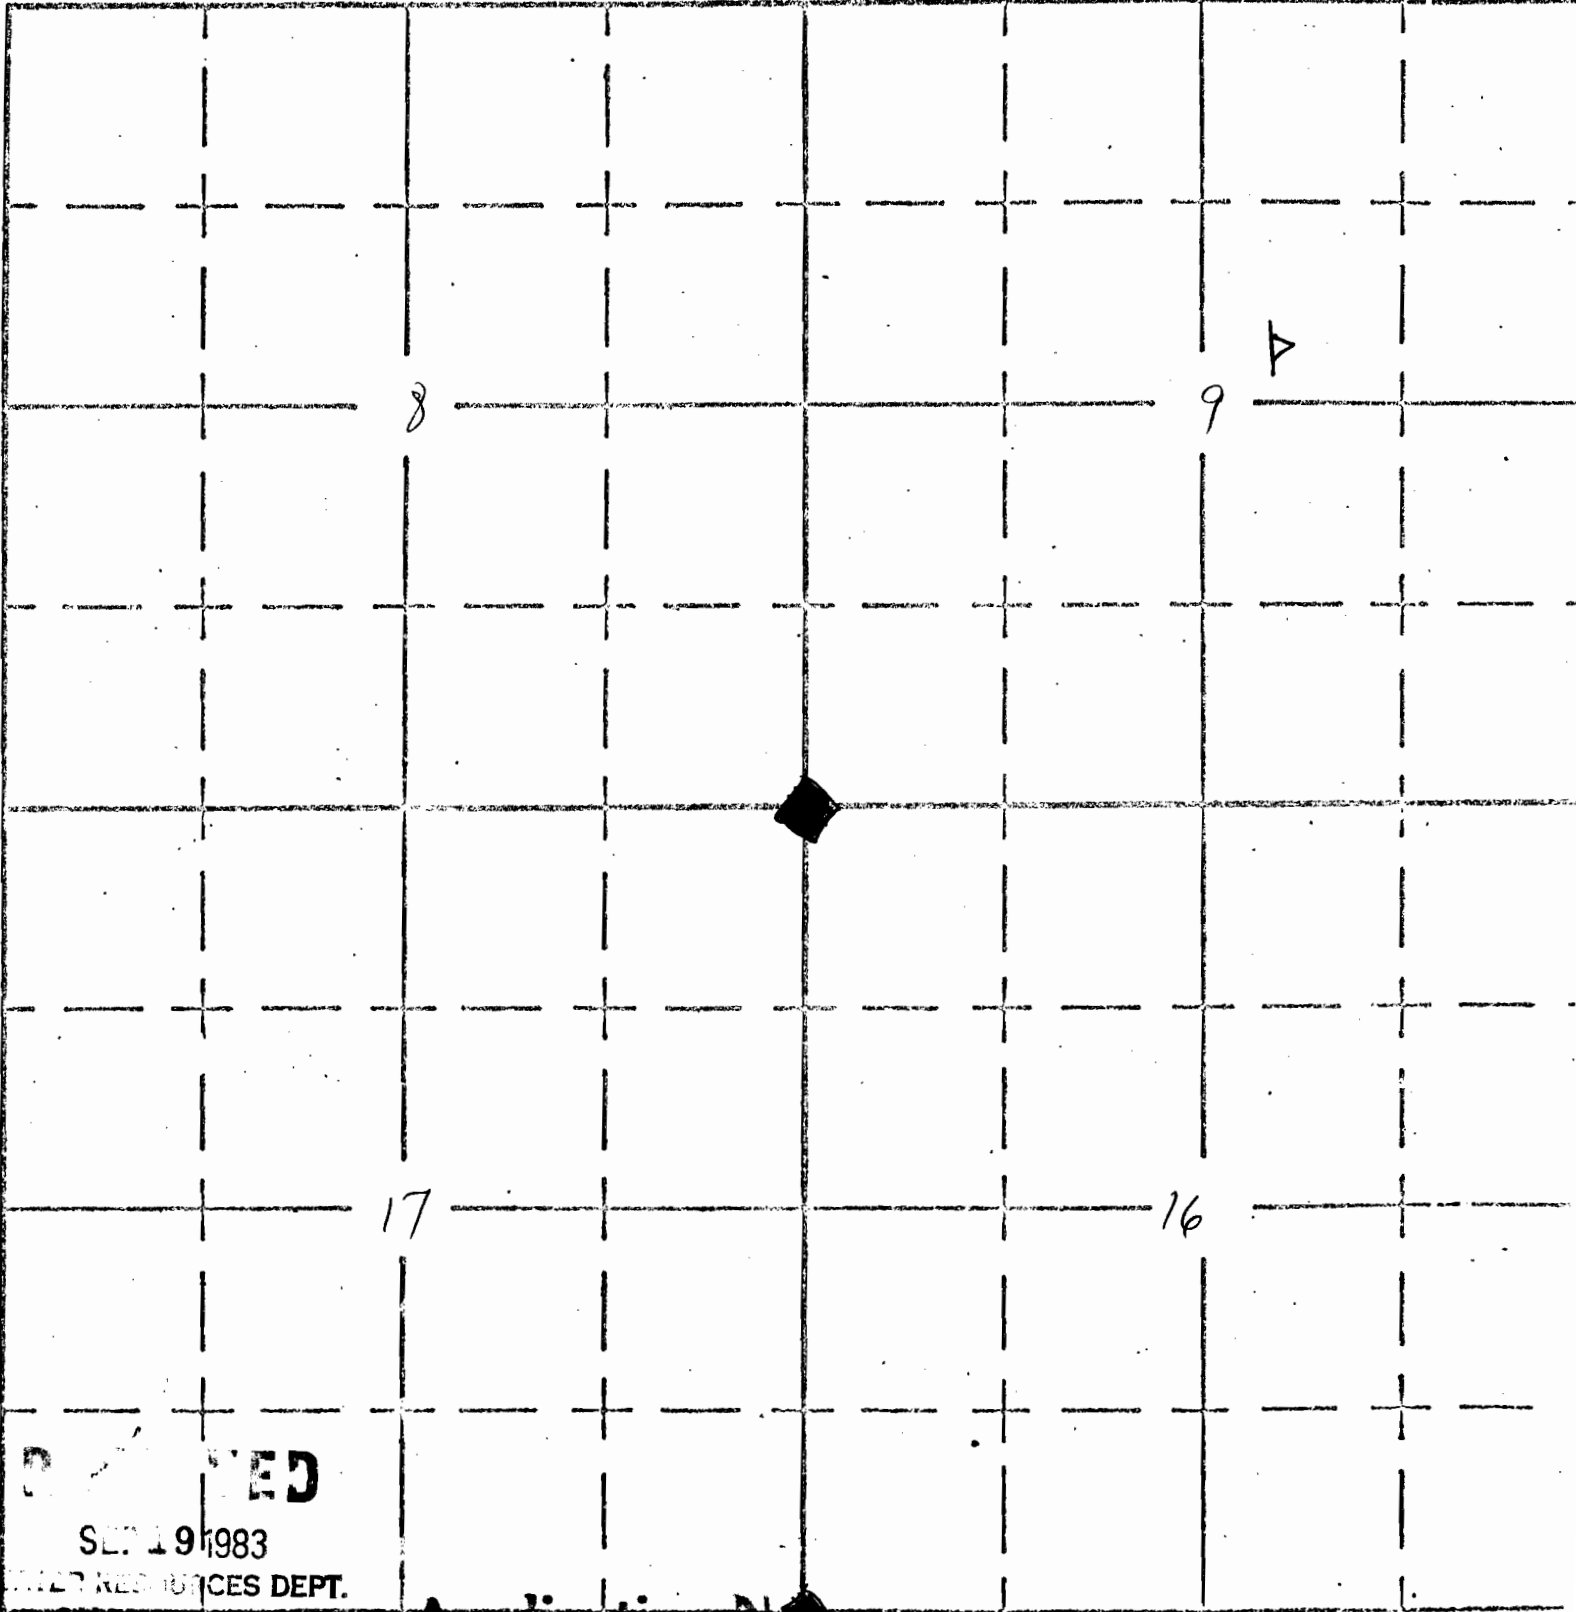

RECEIVED

SEP 19 1983

WATER RESOURCES DEPT.

SALEM, OREGON

Application No.

Permit No.

R-66221

R 9792

APPLICATION No.