


SECTION 22  
SW NE

#5250- Stonyford Res

TOWNSHIP 22S, RANGE 32½ E, W. M.

North

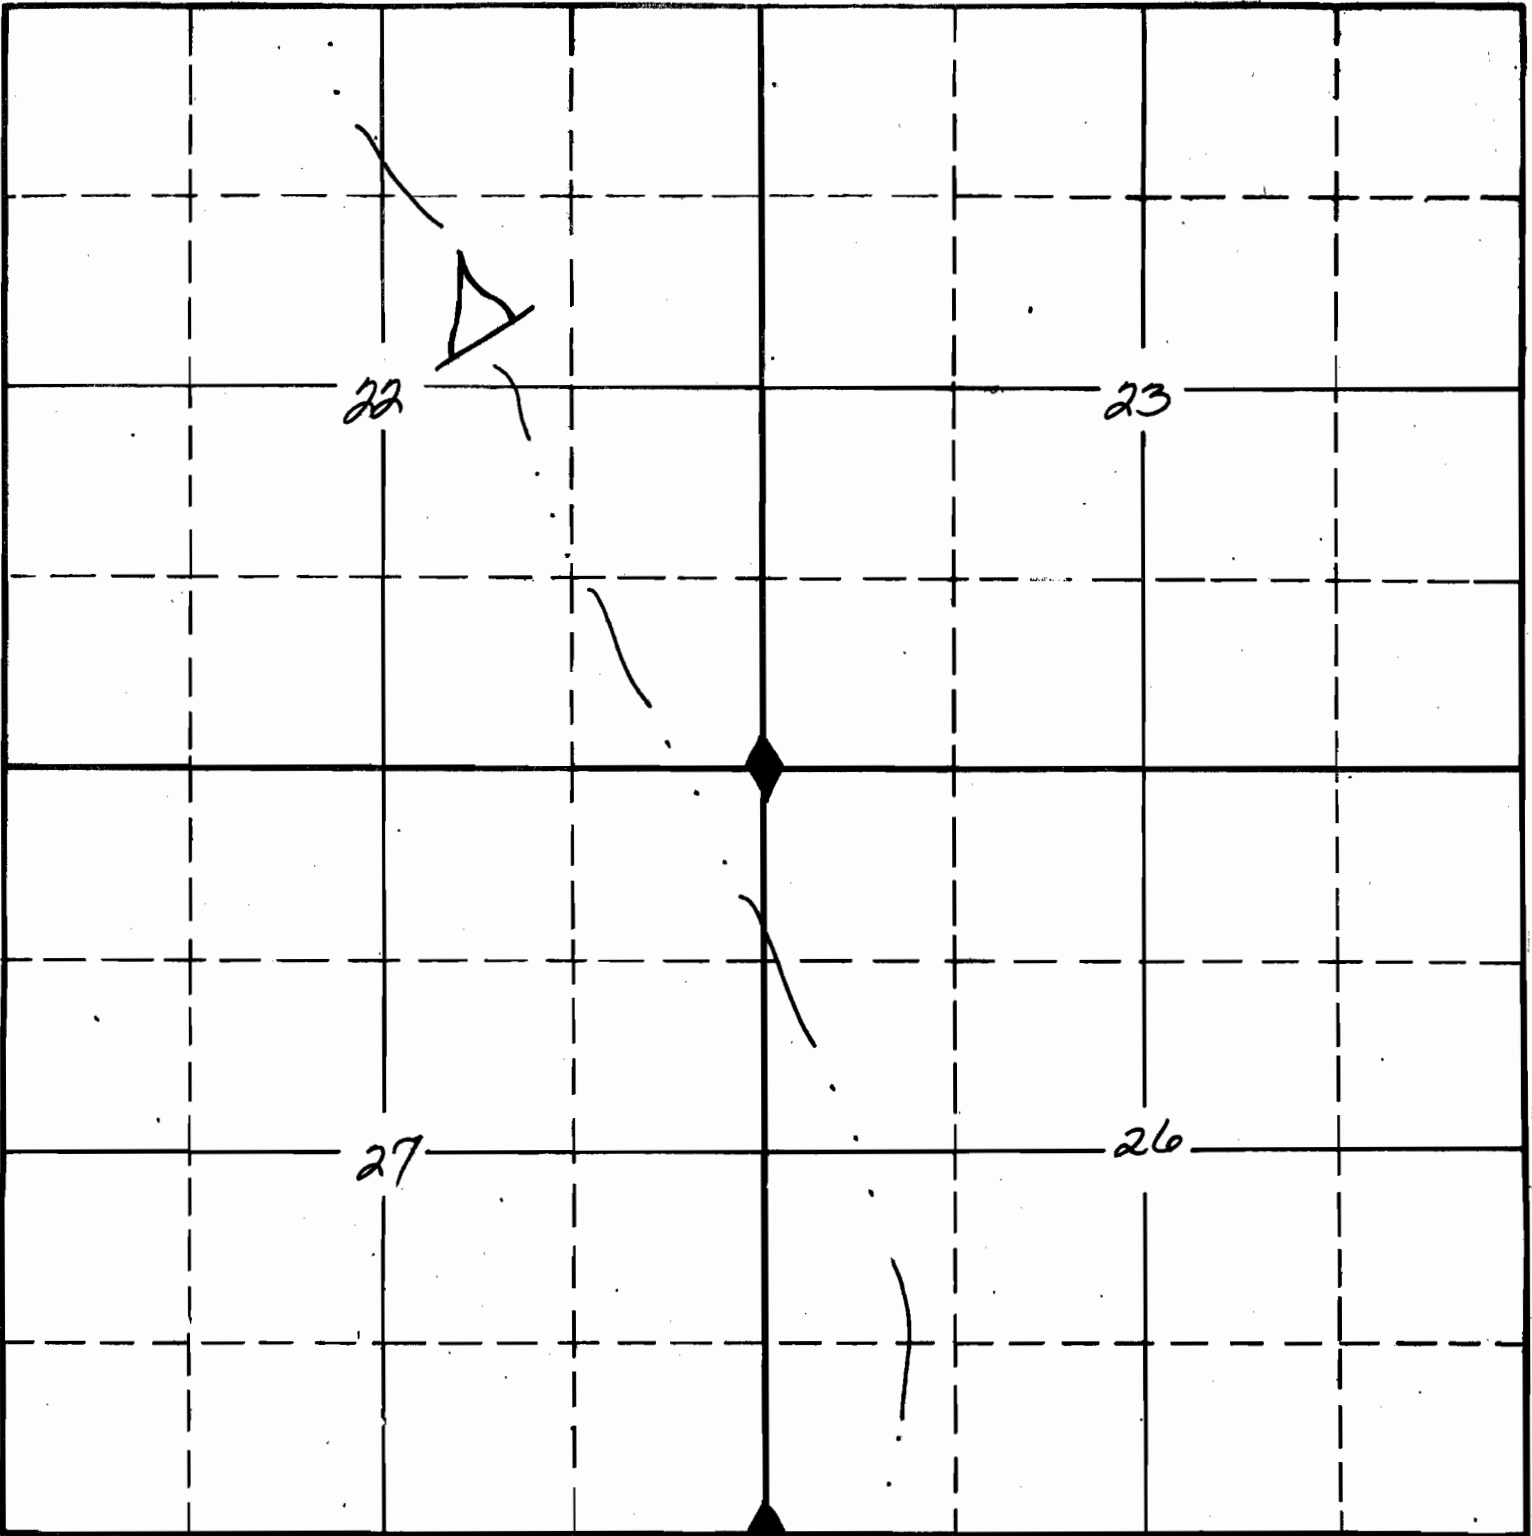

South

RECEIVED  
SEP 19 1993  
LAND & MINES DEPT.  
SALEM, OREGON

APPLICATION No. R-66230  
PERMIT No.  
R 9801