


SECTION 32
NE SE

5357 - Pothole #1 Water hole

TOWNSHIP 28 S, RANGE 37 E, W. M.

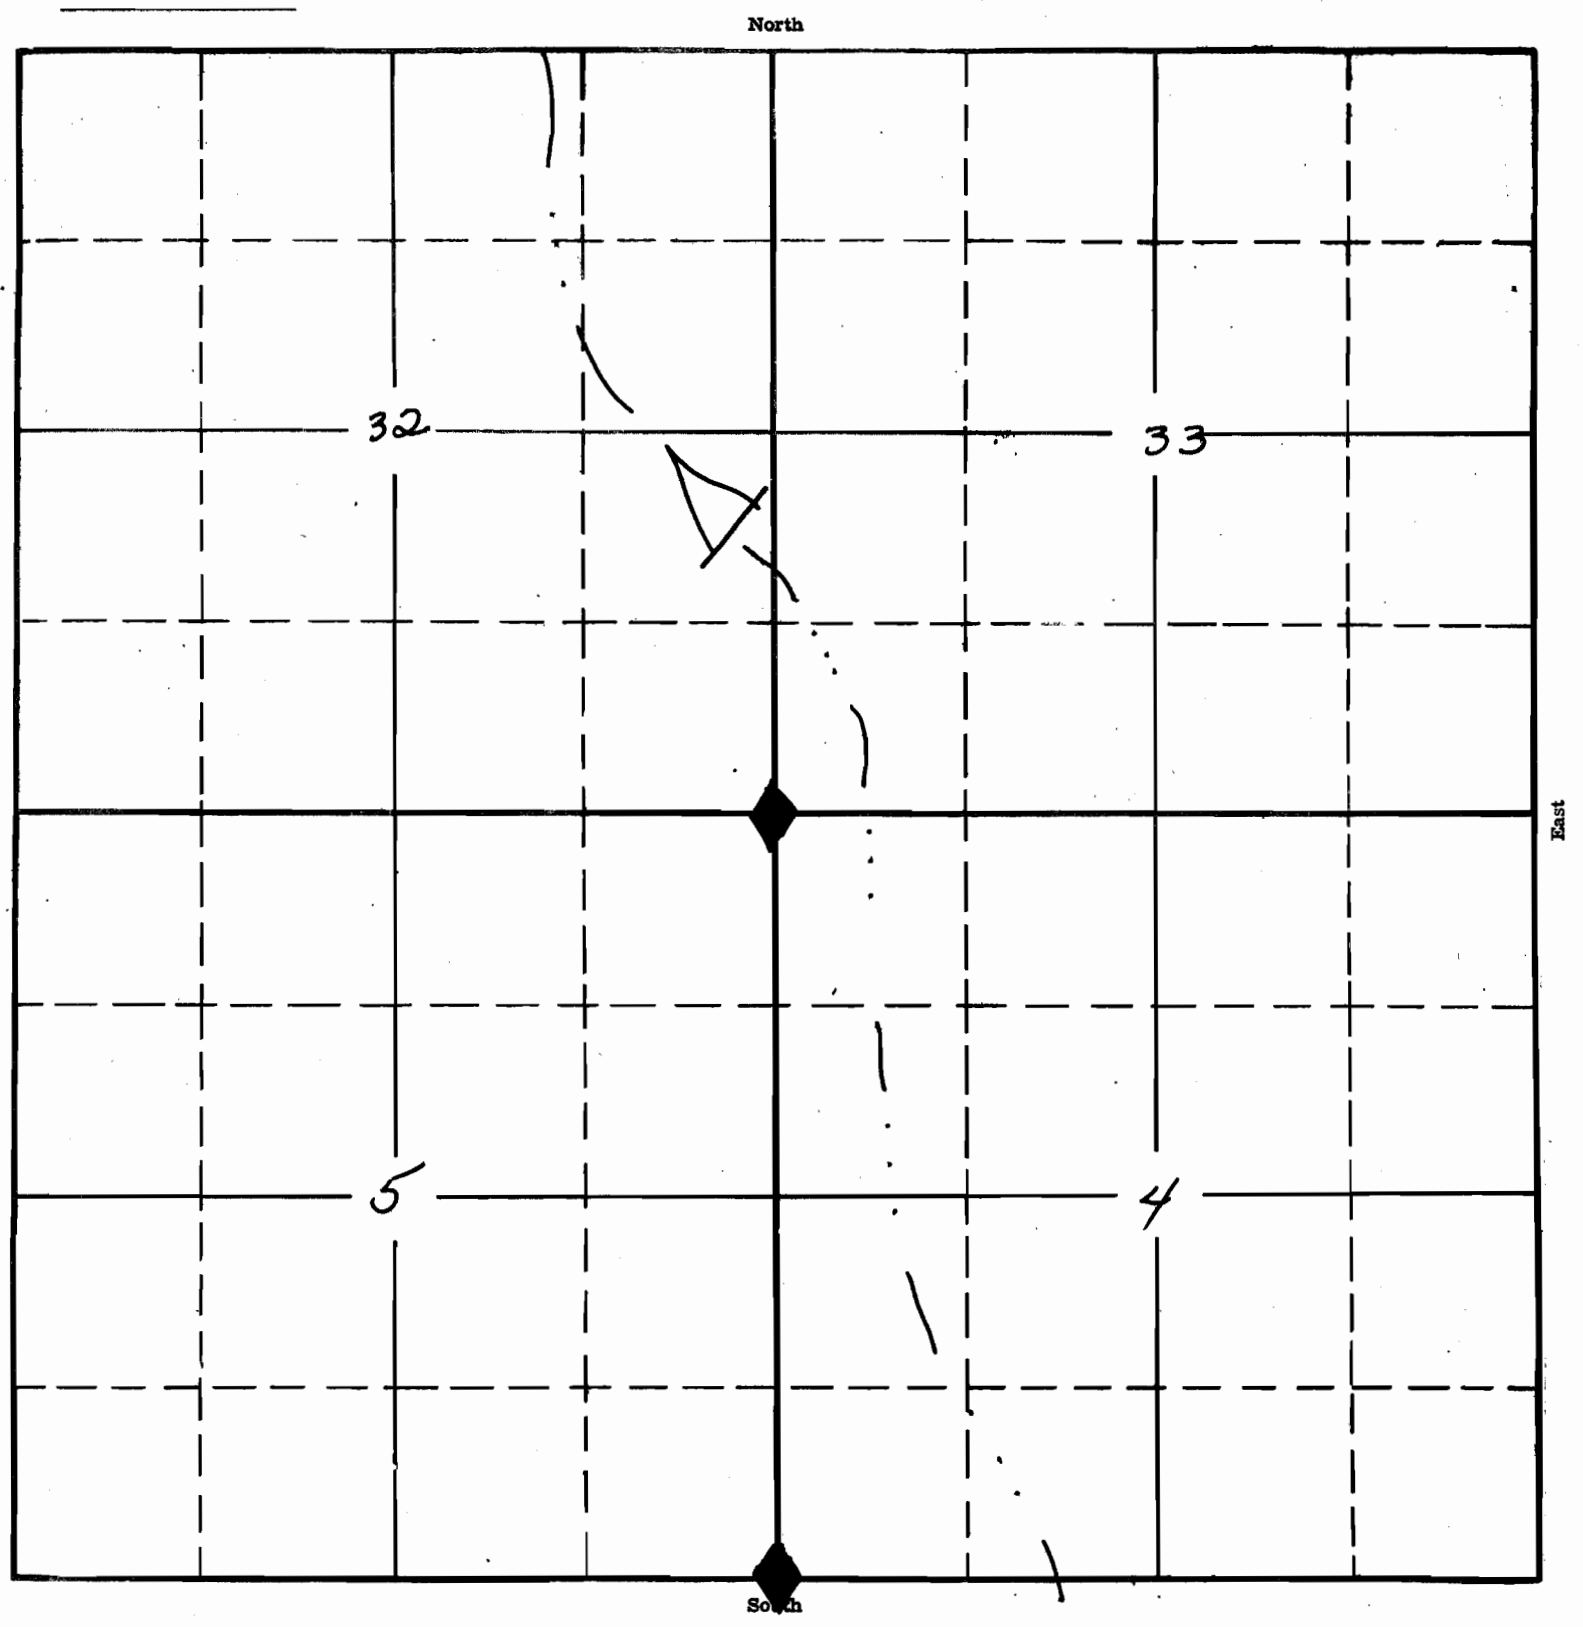

RECEIVED
SEP 19 1983
WATER RESOURCES DEPT.
SALEM, OREGON

APPLICATION No. R-66232
PERMIT No. R 9803