


T. 1S., R. 2W., W.M.

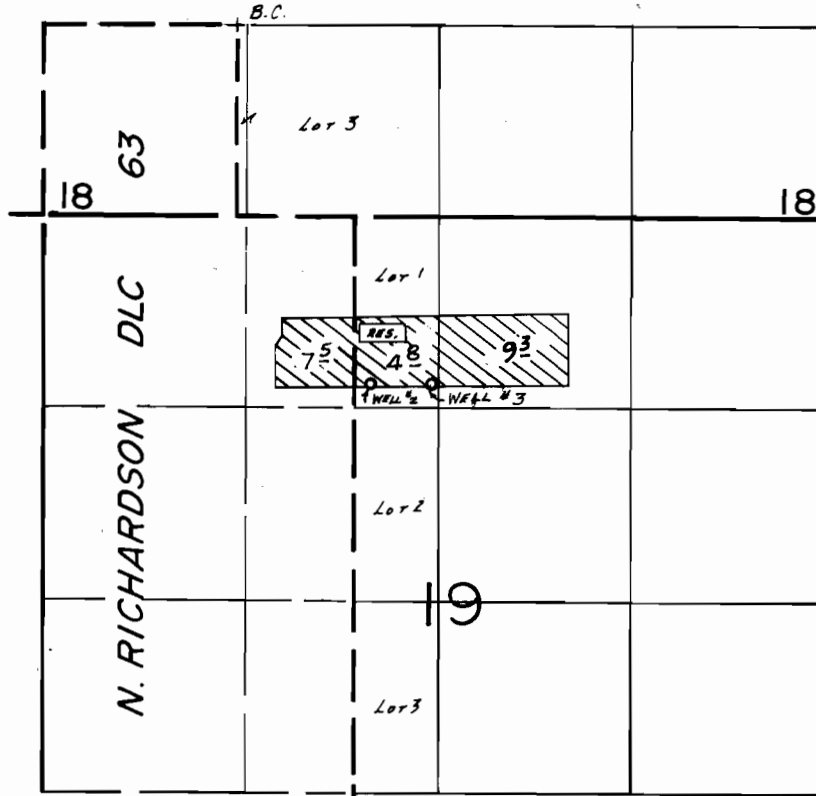

WELLS LOC.: #2-2460'S. § 940'E, #3-2460'S. § 1350'E, BOTH FROM NNE COR. N. RICHARDSON DLC 63.

SCALE: 1"=1320'

FINAL PROOF SURVEY UNDER

Application No. G:65.Q1.. Permit No. G:6.U.7.....
IN NAME OF

.....FRED BARBY.....

Surveyed May 6, 1977, by D.M. NORBY.....
JULY 22 1986 B.W. BISHOP

1-26-87
BWB

DBS-44-27