


T.5S.,R.2W.,W.M.

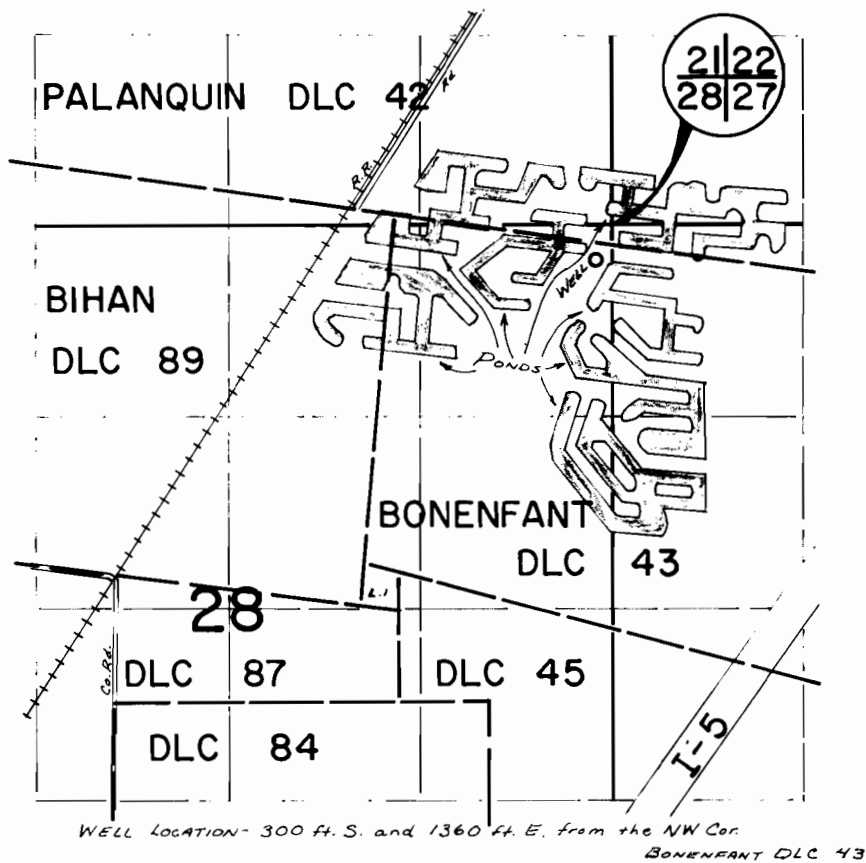

FINAL PROOF SURVEY UNDER

Application No. G-7216.. Permit No. G-6638.....

IN NAME OF
DEPARTMENT OF
FISH AND WILDLIFE.....

Surveyed Oct. 16, 1981., by S. G. BROWN.....