


T. 4 & 5 S., R. 3 W., W.M.

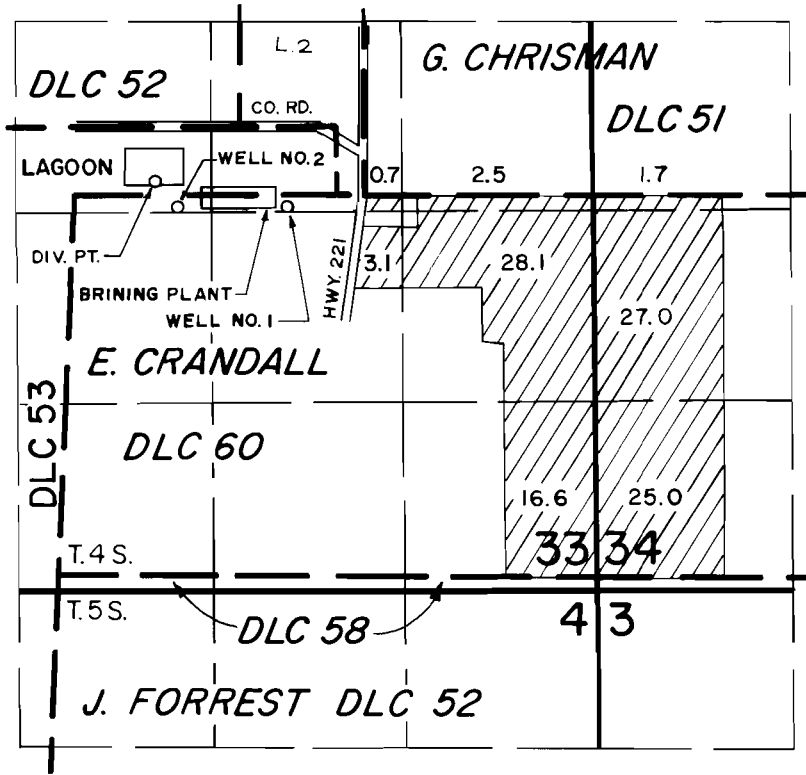

SCALE: 4" = 1 MILE

FINAL PROOF SURVEY UNDER

R-61876 R-8288
 61877 45904
 Application No. G-7135.. Permit No. G-6697.....
 IN NAME OF

.....GRAY & COMPANY.....

Surveyed APR. 27., 1984., by P. Paster.....