


T.5S., R.2W., W.M.

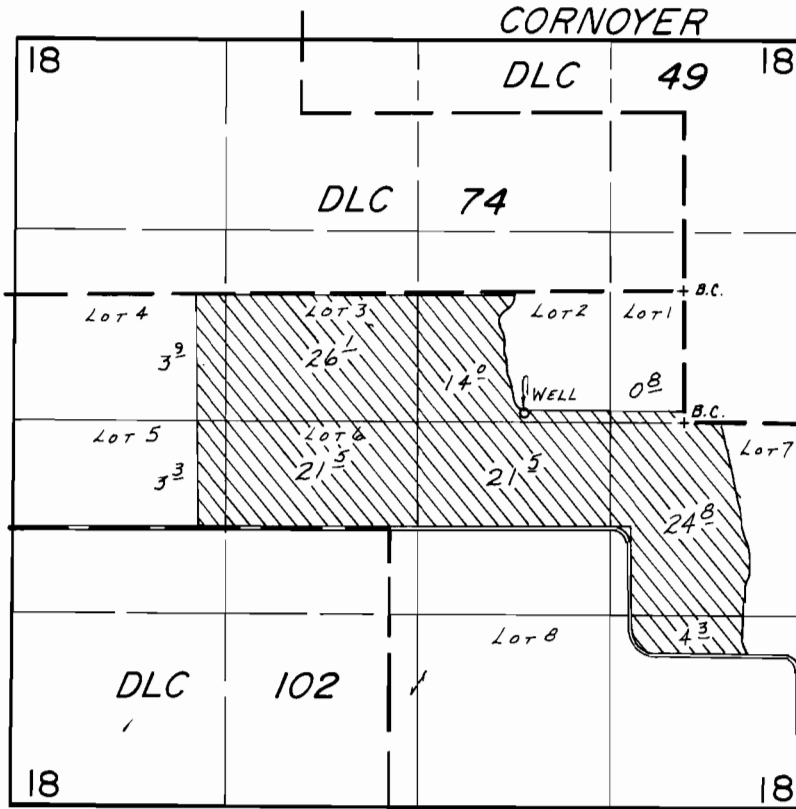

WELL LOC: 60' N. & 1100' W. FROM SOUTHERLY SW COR. CORNOYER DLC 49.

SCALE: 1"=1320'

FINAL PROOF SURVEY UNDER

Application No. G-8191... Permit No. G-7570....
IN NAME OF

.....COLEMAN FARM, INC.....

Surveyed April 18... 1984, by B.W. BISHOP.....