


T. 5S., R. 40E., W.M.

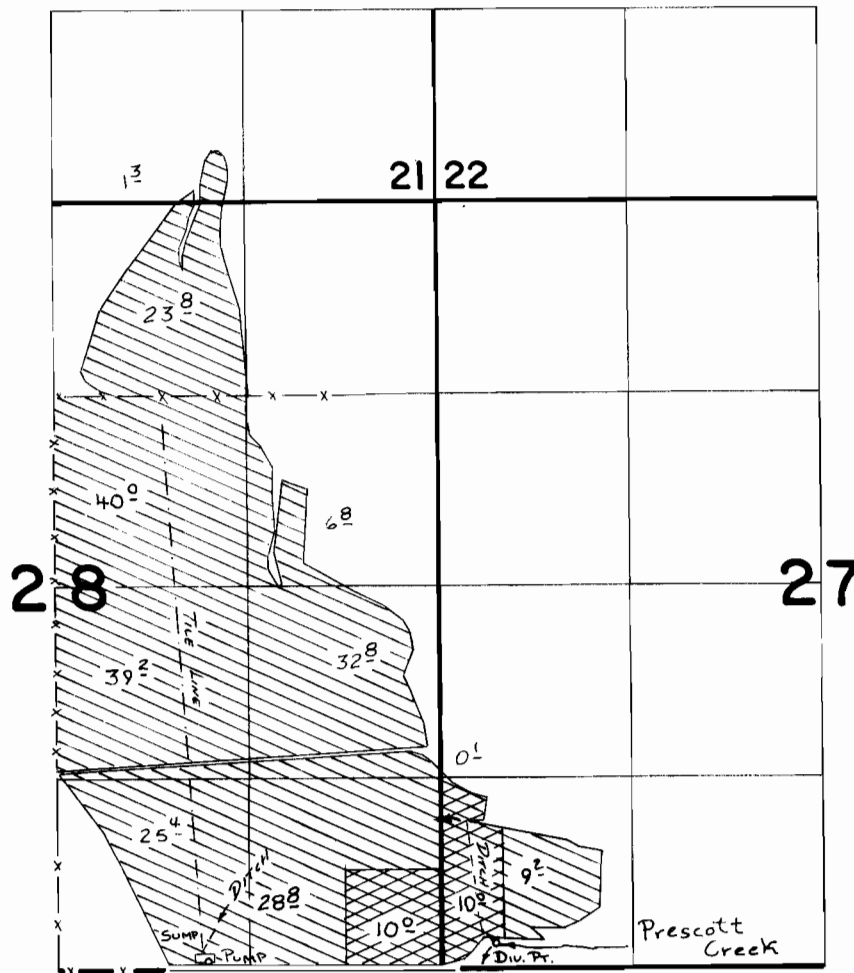

SCALE: 1" = 1320'

SUMP LOCATED 50' N & 1040' E FROM S 1/4 COR. SEC 28
 DIV. PR. LOCATED 170' N. & 370' E FROM SW COR. SEC 27

	PRIM PER. 42263		SUPPL PER. 42263
	SUPPL PER. G-7633		SUPPL PER. G-7633

FINAL PROOF SURVEY
 UNDER

G-8179 **G-7633**
 Application No. **56004** Permit No. **42263**.....
 IN NAME OF

BAR C RANCH, ERNEST W. & K. NEAL CHRISTOPHERSON

Surveyed 7-16..... 1985., by V.H. Church.....