


T.15S., R.12E., W.M.

NE 1/4 NE 1/4 Sec. 12

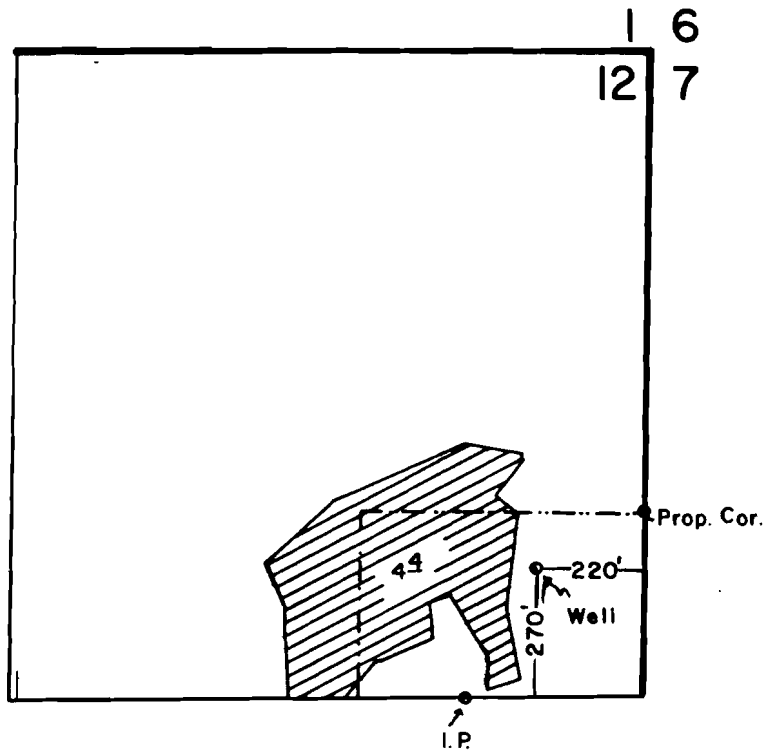

SCALE: 1" = 400'

FINAL PROOF SURVEY
UNDER

Application No. G-8291, Permit No. G-7811.....
IN NAME OF

PHILLIP A. NANCE

Surveyed OCT. 12, 1983, by D. PANTHER.....

RECEIVED

2-27-89

WATER MASTER DISTRICT #11

BY [signature]