


G7828  
58861

T. 4N., R. 24E., W.M.

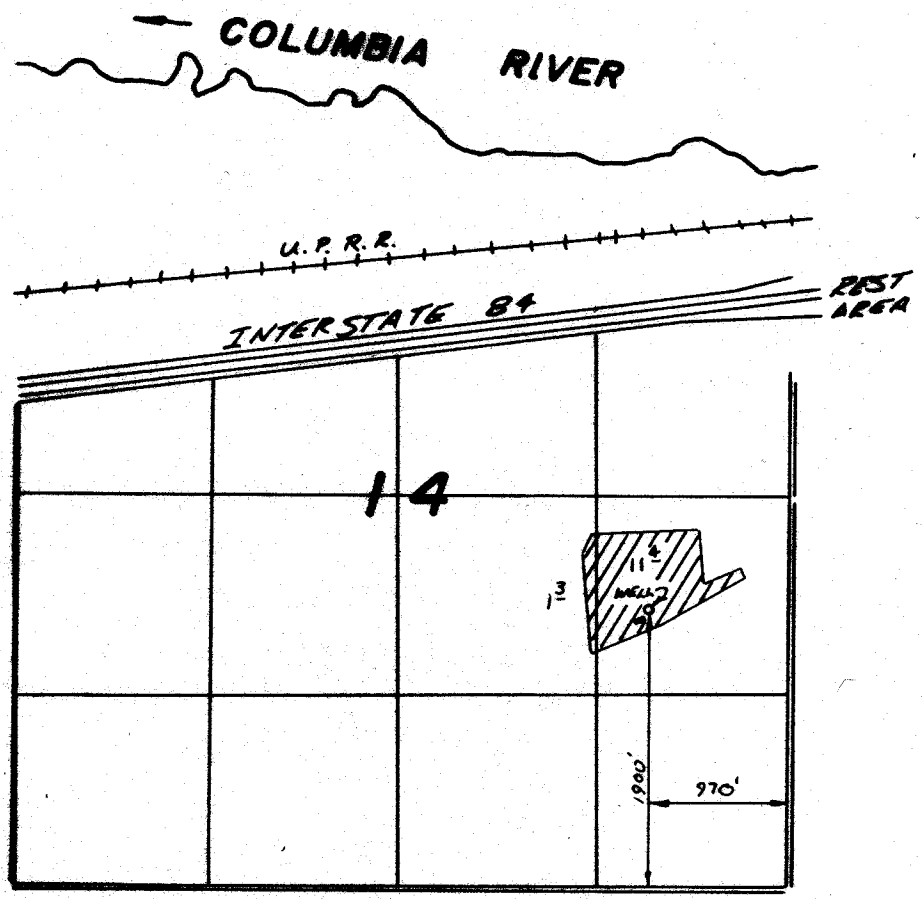

**FINAL PROOF SURVEY**  
UNDER

Application No. G-8295 Permit No. G-7828  
IN NAME OF

LARRY DUANE EADES

Surveyed 1-2 1982, by Unuma Co. Church