


T. 10S., R. 40E., W. M.

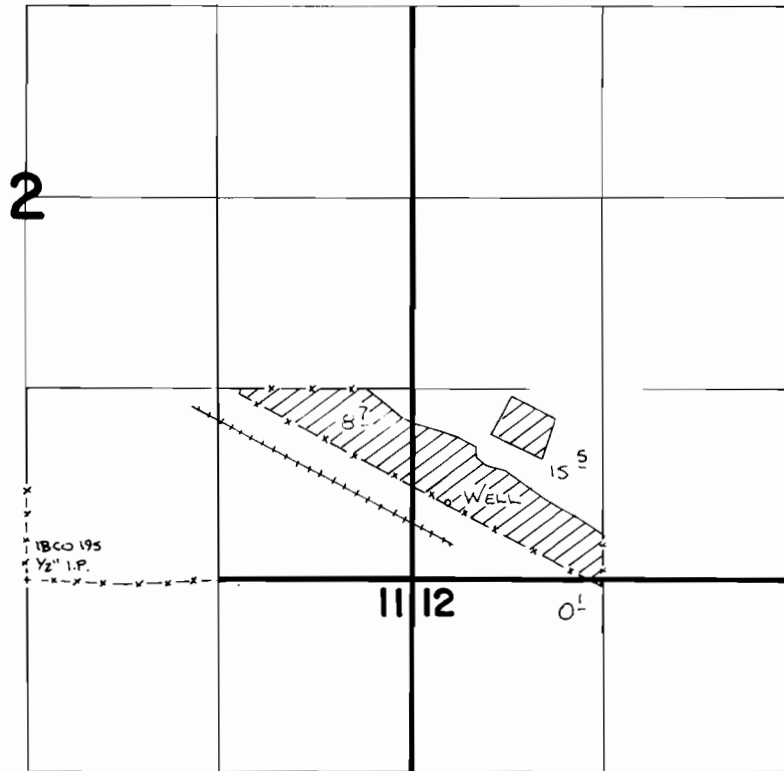

WELL LOC: 520' N. & 240' E. FROM SW COR. SEC. 1

1" = 1320'

FINAL PROOF SURVEY
UNDER

Application No. **G:8823** Permit No. **G:8188...**
IN NAME OF

RANDY DUNBAR

Surveyed 4-5 1986, by V. Church