G-8202
58863

T.37S.R.20E.W.M.

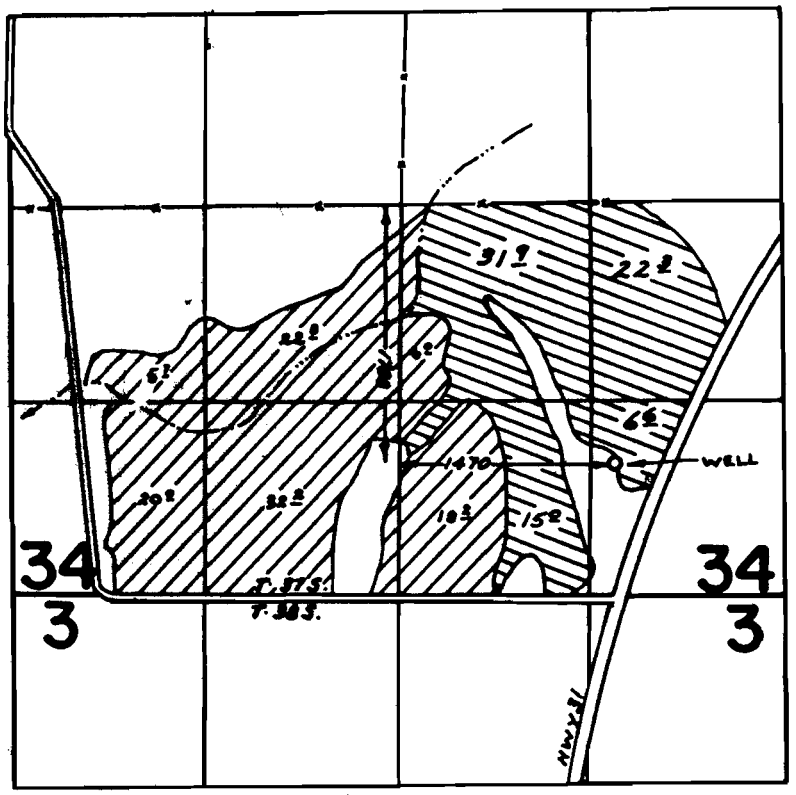

· App. G-4112

· App. G-8825

FINAL PROOF SURVEY
UNDER

Application No. ~~G-4112~~ G-8825 Permit No. ~~G-3960~~ G-8202
IN NAME OF

ROBERT L. WEIR

Surveyed ~~July 14~~, 1975, by L. NUNN
Nov. 1, 1976 by R. MUCKEN
APR. 24, 1978 by H. DAGGETT
JUNE 6, 1980, by C.L. HUGHES

R.G.M.
CNZ-4KK-57