


T. 39 S., R. 5 W., W.M.

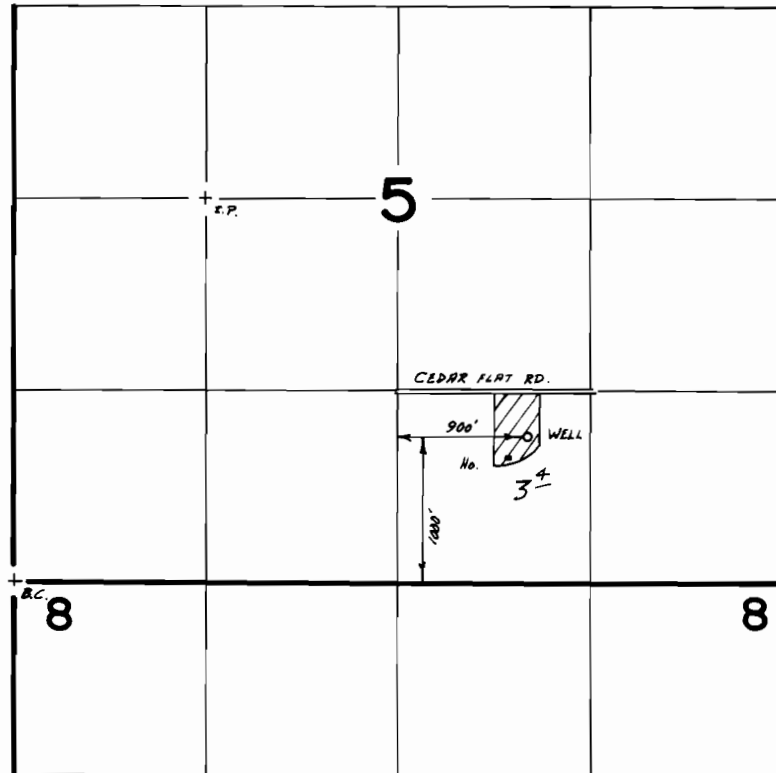

Scale 1"=1320'

FINAL PROOF SURVEY
UNDER

Application No. G-8808 Permit No. G-8206
IN NAME OF

MICHAEL J. & HENRIETTA R. BUCK

Surveyed Aug. 13, 1984, by B.S. JAMES