


G-8227
588LS

T.13S.,R.30E.,W.M.

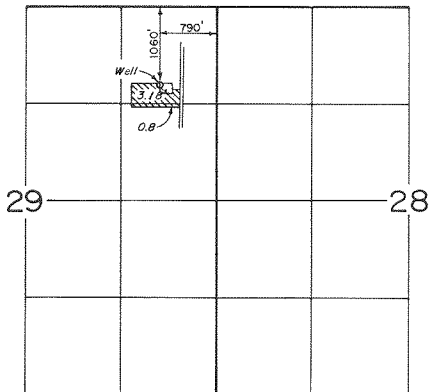

FINAL PROOF SURVEY
UNDER

Application No. G-8726 Permit No. G-8227
IN NAME OF

LEO A. WISE

Surveyed AUG 31, 1981, by *Al Brown*