


G-8297

58868

T.13S.,R.31E.,W.M.

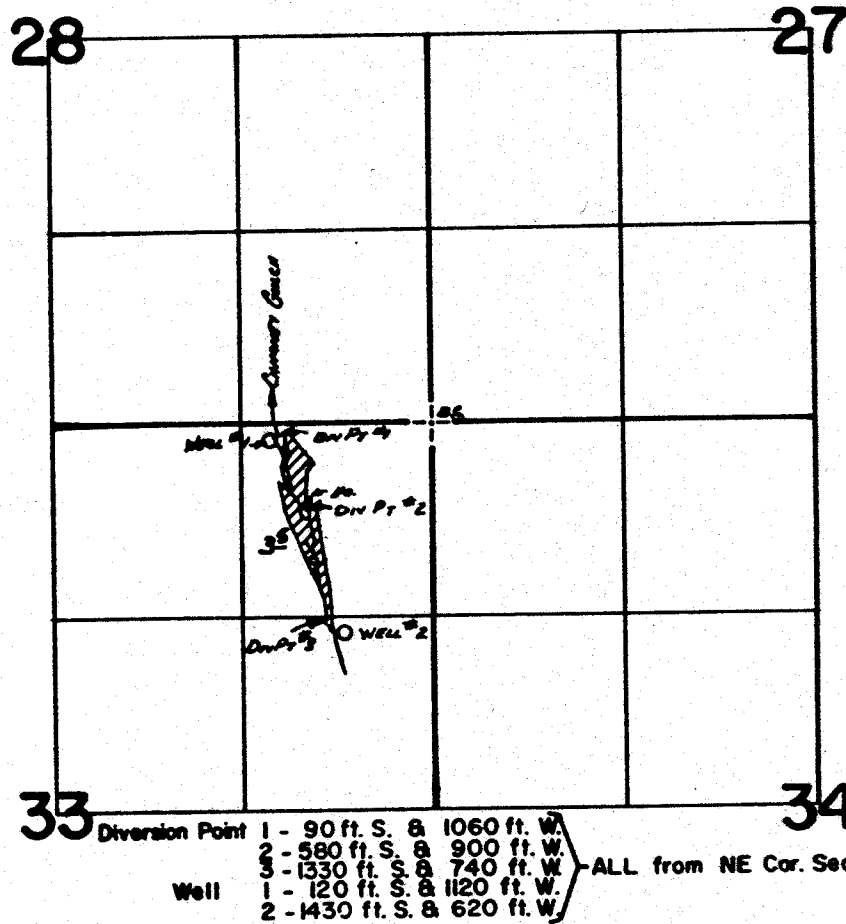

FINAL PROOF SURVEY

UNDER

57517 43526
 Application No. G-8849 Permit No. G-8297....
 IN NAME OF

.....KEITH LYONS.....

Surveyed July..22.. 1983., by R.W.Cettel.....