


P. 43526

T.13S.,R.31E.,W.M.

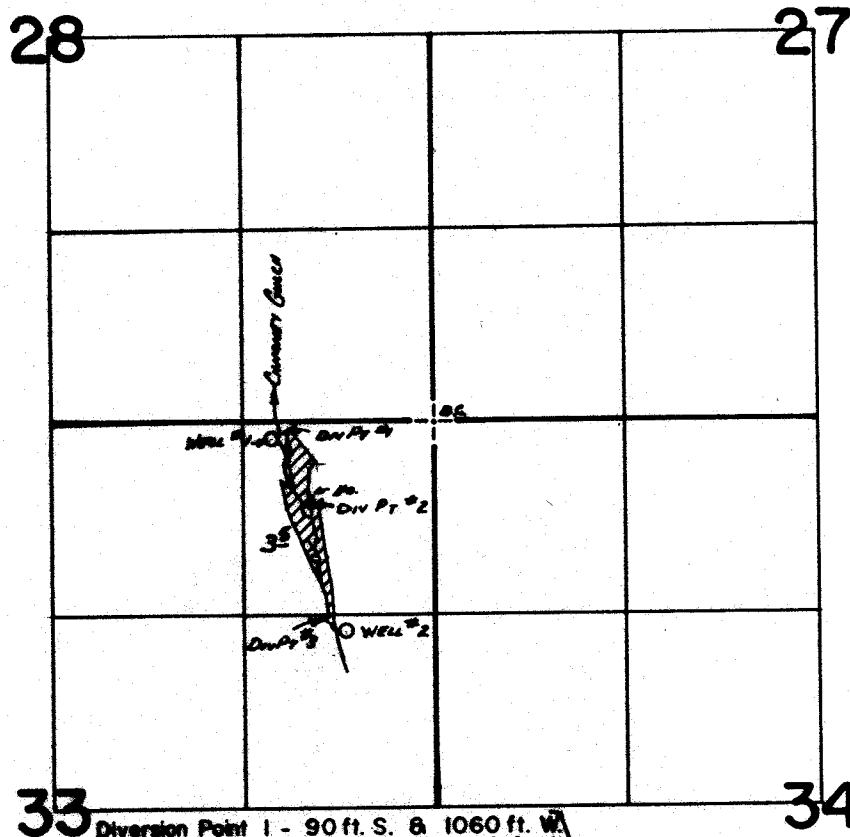

33 Diversion Point 1 - 90 ft. S. & 1060 ft. W.
2 - 580 ft. S. & 900 ft. W.
3 - 1330 ft. S. & 740 ft. W. } ALL from NE Cor. Sec. 33
Well 1 - 120 ft. S. & 1120 ft. W.
2 - 1430 ft. S. & 620 ft. W.

FINAL PROOF SURVEY UNDER

57517 43526
Application No. G-8849 Permit No. G-8297....
IN NAME OF

KEITH LYONS

Surveyed July 22, 1983, by R.W. Cattel.....