


T.19S.,R.1W.,W.M.

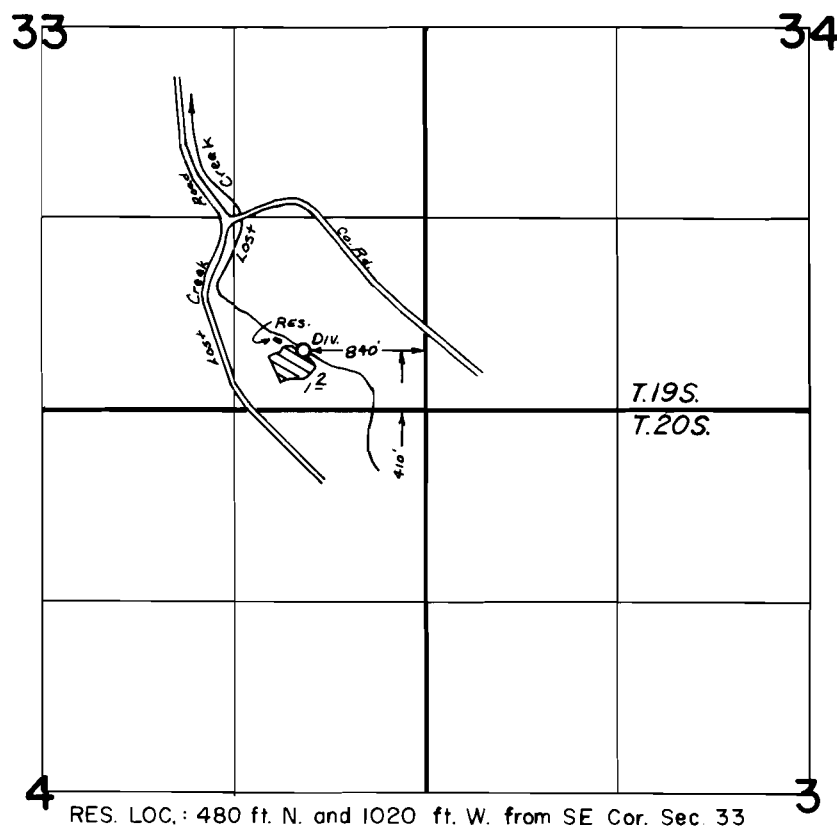

FINAL PROOF SURVEY
UNDER

Application No. R-56262 56261 Permit No. R-6698 42320
IN NAME OF

JOHN A. & BETTY G. HORTON

Surveyed Sept. 15, 1981, by S. C. BROWN