


R-8214

58874

T.40 S., R.19 E., W.M.

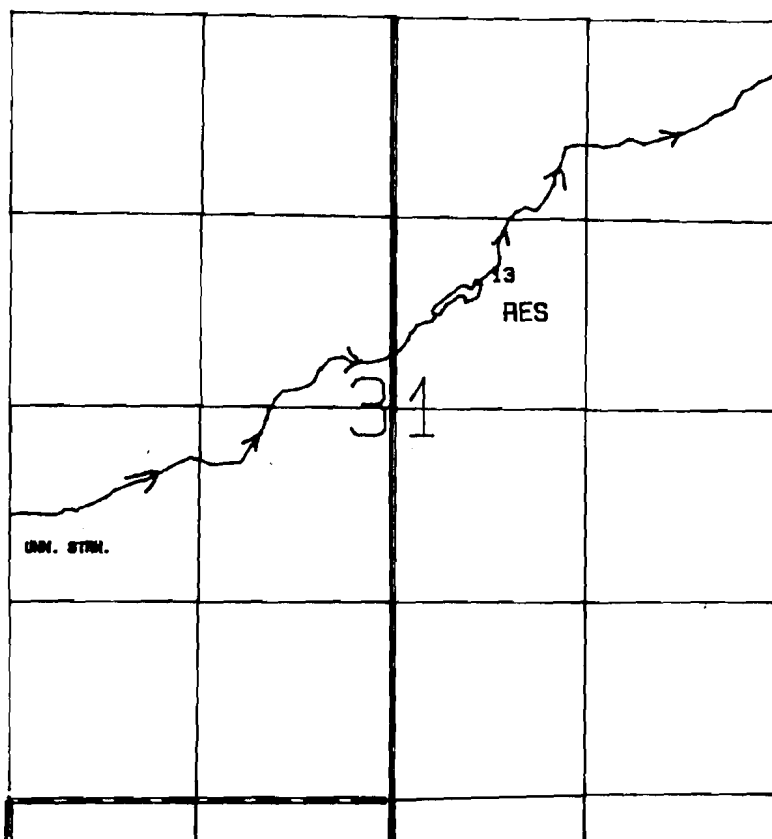

SCALE: 1 = 1320

DAM LOCATED 1810 FT. S. AND 580 FT. E. FROM N. 1/4 COR. SEC. 31

FINAL PROOF SURVEY

UNDER

56562

45379

Application No. R-56192 Permit No. R-8214

IN NAME OF

ERNEST & MARY MCALPEN

Surveyed Oct.17,1987 By B.S.JAMES

Photo: 379-85B DLM