


45379
58875

T. 40 S., R. 19 E., W.M.

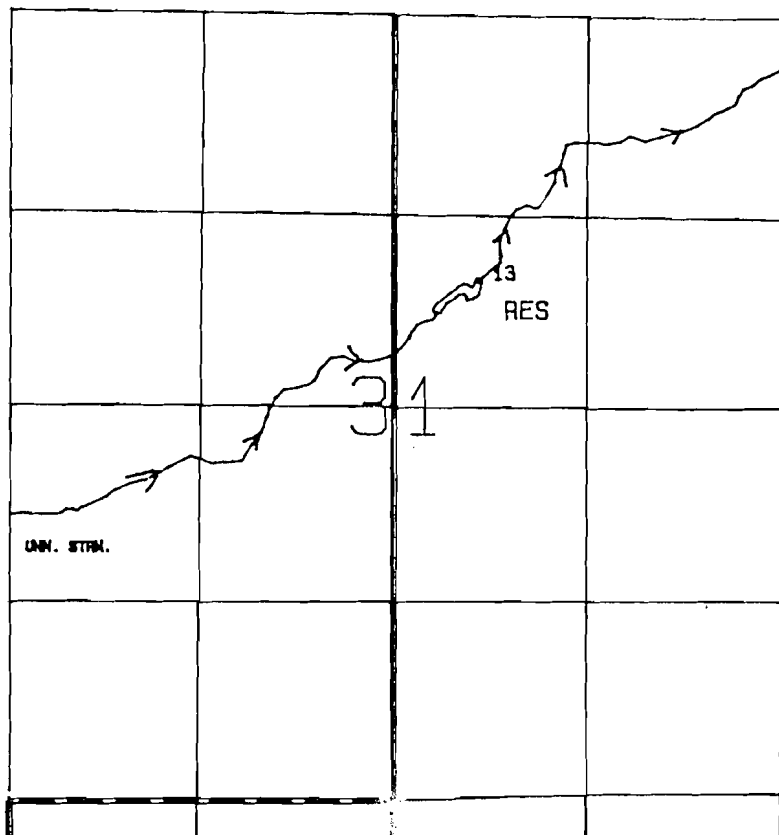

SCALE: 1 = 1320

DAM LOCATED 1810 FT. S. AND 580 FT. E. FROM N. 1/4 COR. SEC. 31

FINAL PROOF SURVEY

UNDER

56562

45379

Application No. R-56192 Permit No. R-8214

IN NAME OF

ERNEST & MARY MCALPEN

Surveyed Oct. 17, 1987 By B.S. JAMES

Photo: 379-858 DLM