


T. 1N., R. 39E., W. M.

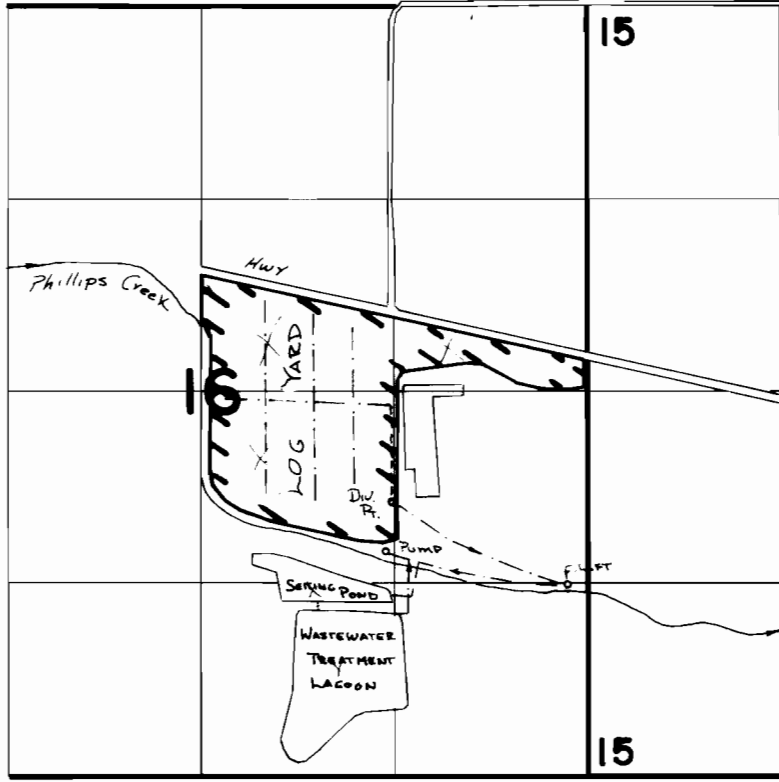

SC-1-1320

Div. Pt. Loc: 1300'N. & 150'W. FROM SE COR. SEC 16  
Res: Loc: 1100'N. & 1300'W. FROM SE COR SEC 16

**FINAL PROOF SURVEY**  
UNDER

**R-54682**      **R-6481**  
Application No. **54683** Permit No. **40678**...  
IN NAME OF

**BOISE CASCADE CORPORATION**

Surveyed 5-22 1986, by V.L. Church