


T. 13S., R. 1W., W.M.

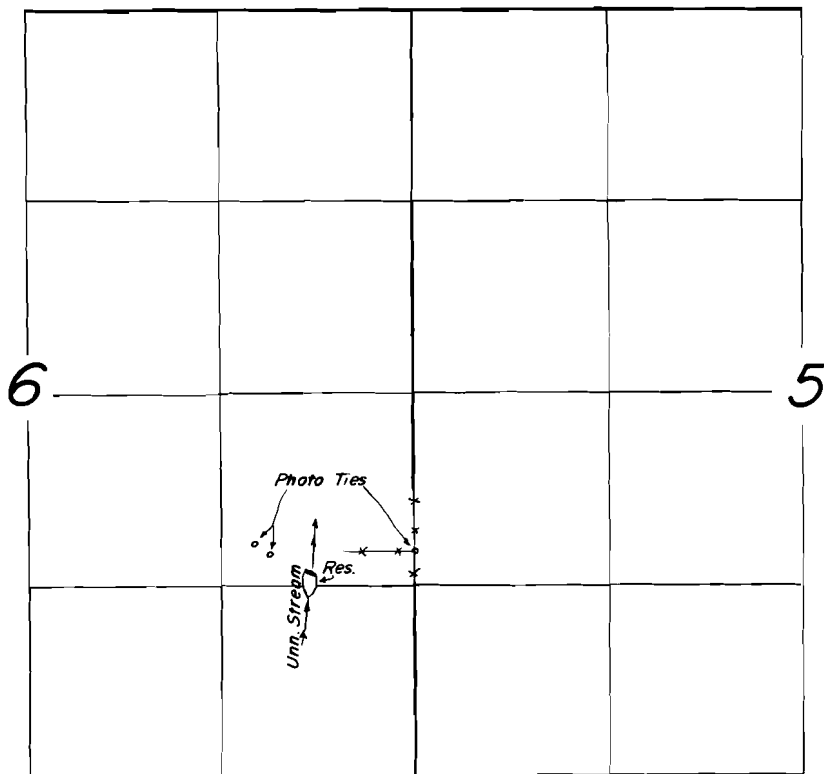

Div. Pt. Loc.: 1250' S. & 600' E. from NW Cor. NE 1/4 SE 1/4 Sec. 6.

Scale: 1" = 1320'

FINAL PROOF SURVEY UNDER

R-58327 *R-7796*
Application No. *58328* Permit No. *43926*
IN NAME OF

G. M. & GARLAND E. WARREN

Surveyed *JUNE 15, 1984*, by *L. TOLL*

PTS-1984 Z
DFM-20-145

TMW