


*T. 13S., R. 1W., W.M.*

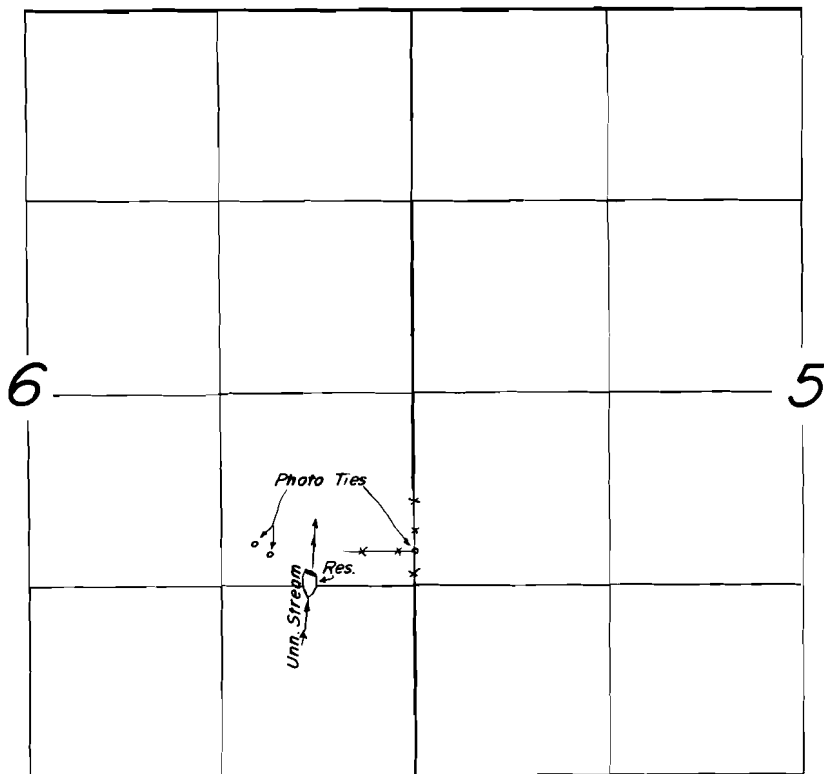

*Div. Pt. Loc.: 1250' S. & 600' E. from NW Cor. NE 1/4 SE 1/4 Sec. 6.*

*Scale: 1" = 1320'*

# FINAL PROOF SURVEY

UNDER

*R-58327*      *R-7796*  
Application No. *58328* Permit No. *43926*

IN NAME OF

*G. M. & GARLAND E. WARREN*

Surveyed *JUNE 15, 1984*, by *L. TOLL*

*PTS-1984 Z*  
*DFM-20-145*

*TMW*