


T. 2 S., R. 4 W. WM.

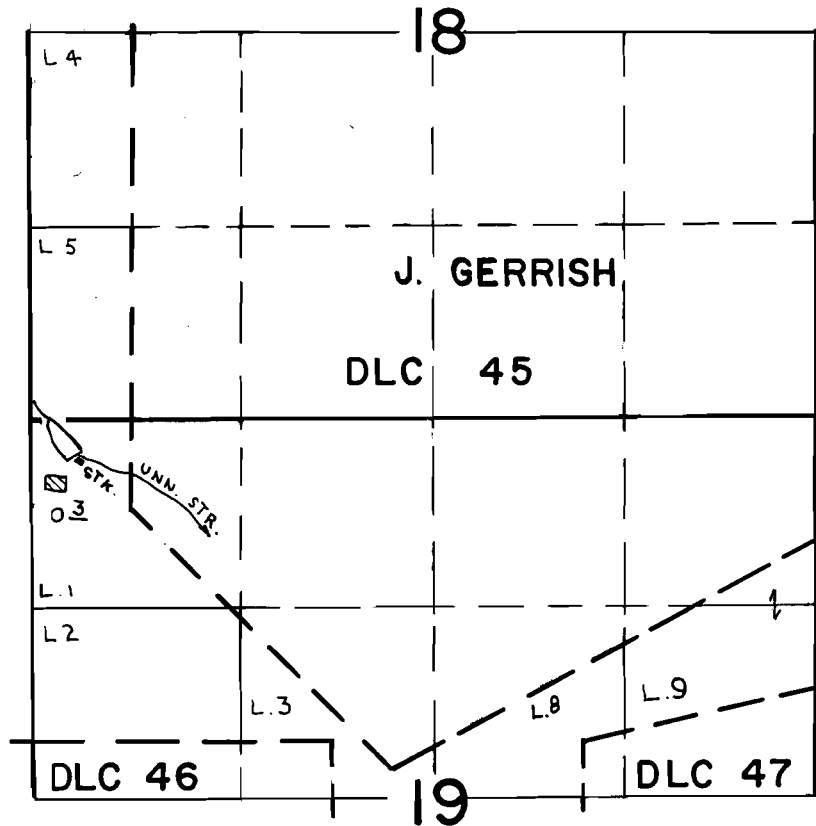

SCALE
1" = 1320'

DIV. PT. LOC. 370' N. & 350' W. OF SW COR. DLC 45

FINAL PROOF SURVEY
UNDER

R 61012 R 8224

Application No. 61013 Permit No. 45450

IN NAME OF

KENNETH B. MOORE

Surveyed AUG 23, 1984, by P. PAGTER