


R-8331

58884

T.41 S., R.20 E., W.M.

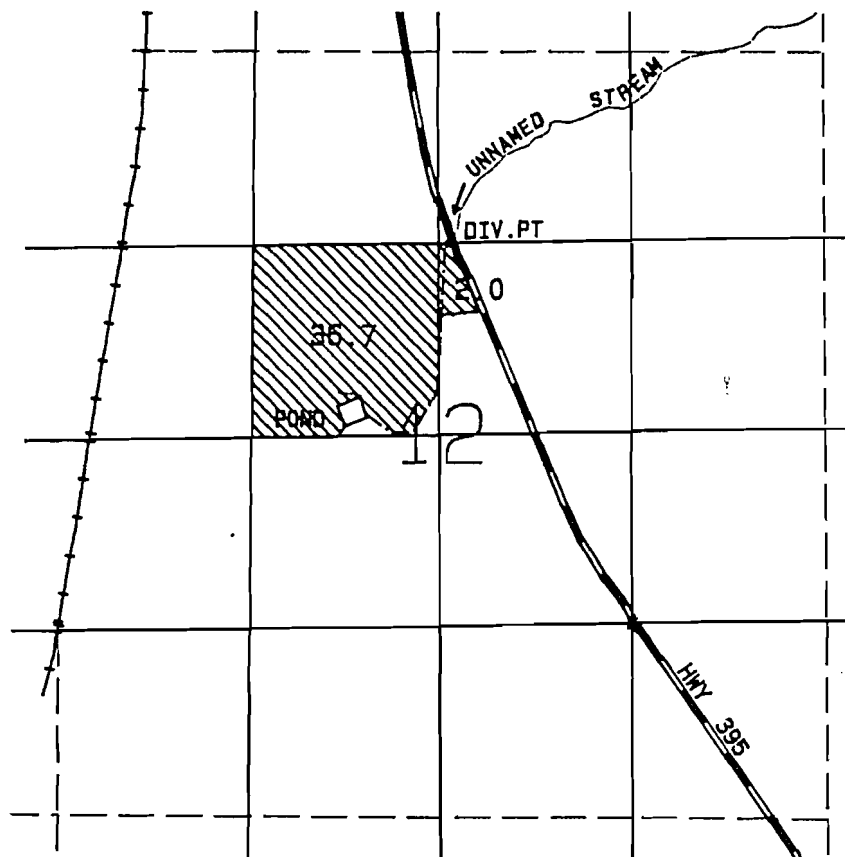

SCALE: 1" = 1320'

DIV. PT. LOCATED 1330 FT. S. AND 70 FT. E. FROM N1/4 COR. SEC. 12

FINAL PROOF SURVEY
UNDER

APPLICATION NO. R-61697 PERMIT NO. R-8331

APPLICATION NO. 61698 PERMIT NO. 46197

IN NAME OF

JEFFREY VOZZA

Surveyed Oct. 16, 1987 By V.L. CHURCH

Photo: 38K-182 JCL