


R-9692
58887

T.39 S., R.19 E., W.M.

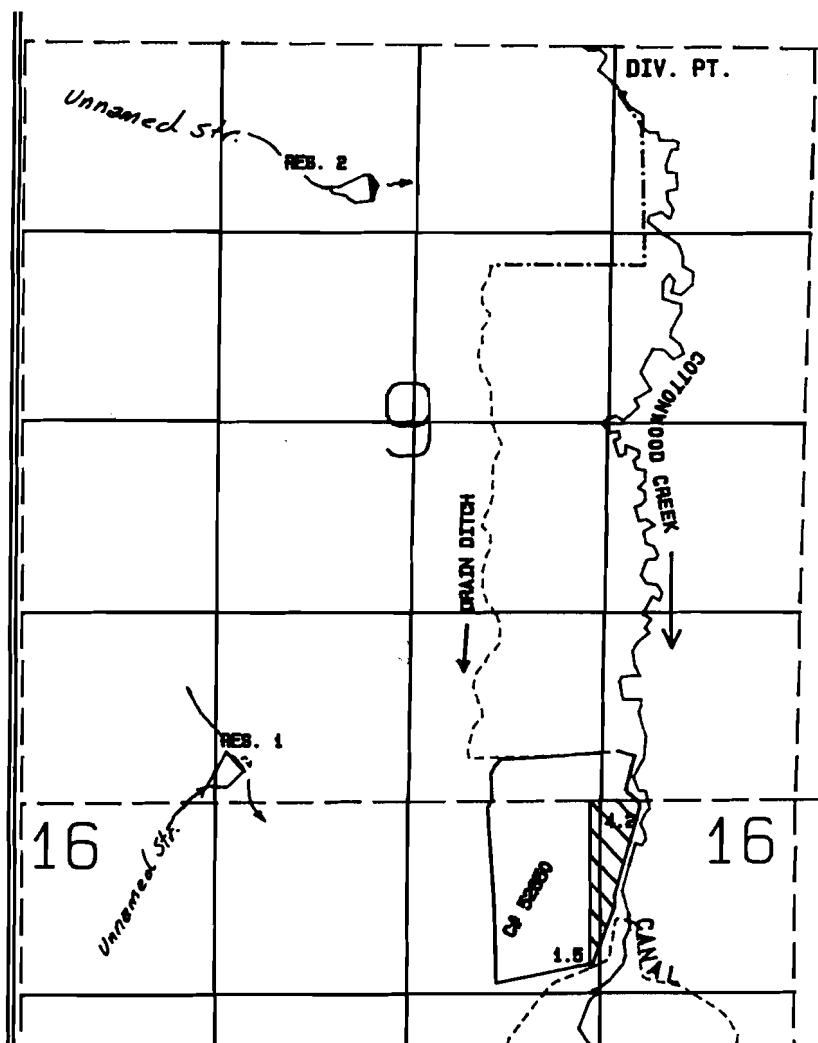

SCALE: 1" = 1320'
DIV. PT. LOCATED 310 FT. S. AND 1310 FT. W. FROM NE COR. SEC. 9
RES. 1 LOCATED 280 FT. N. AND 1480 FT. E. FROM SW COR. SEC. 9
RES. 2 LOCATED 950 FT. S. AND 3040 FT. W. FROM NE COR. SEC. 9

FINAL PROOF SURVEY
UNDER

R-68028

R-9692

R-68027

R-9691

Application No. 68232 Permit No. 49149

IN NAME OF

MATTHEW OUTLAND

Surveyed OCT. 15, 1987 BY M.J. MATTICK

Photo: 41037-379-99C LN