


T. 39 S., R. 18 E., W.M.

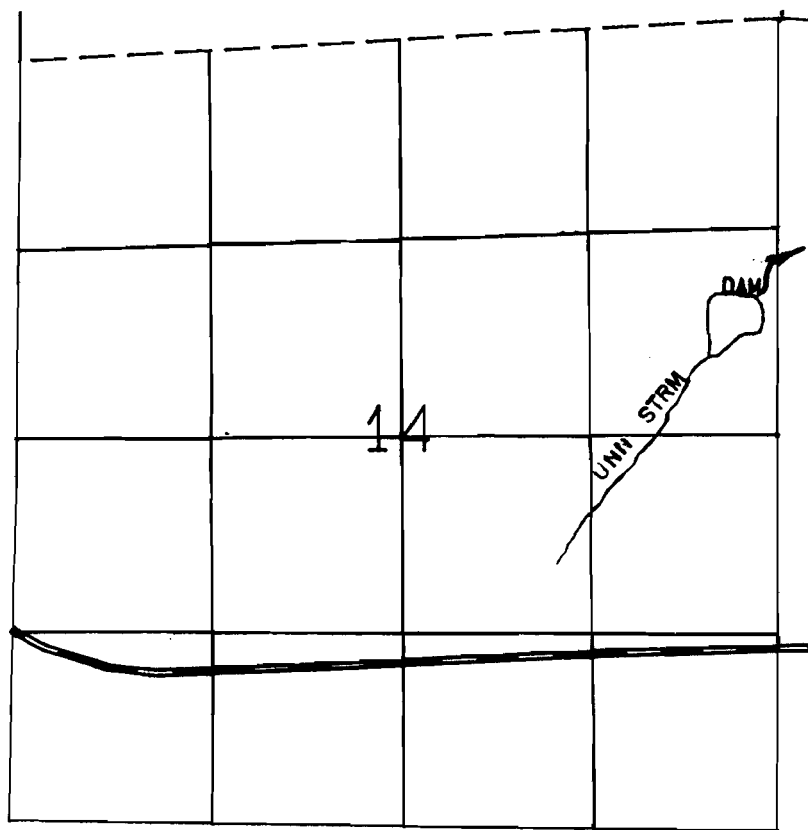

DAM LOCATED 950 FT. N. AND 150 FT. W. FROM E. 1/4 COR. SEC 14

SCALE: 1" = 1320'

FINAL PROOF SURVEY

UNDER

Application No. R-68643 Permit No. R-10623

IN NAME OF

PERRY PARMELEE

Surveyed Oct. 19, 1987 By M. J. MATTICK

Photo: 41037 378-810 DLM